



SECTION 2, T.4S., R.1E., W.M.
CLACKAMAS COUNTY, OREGON

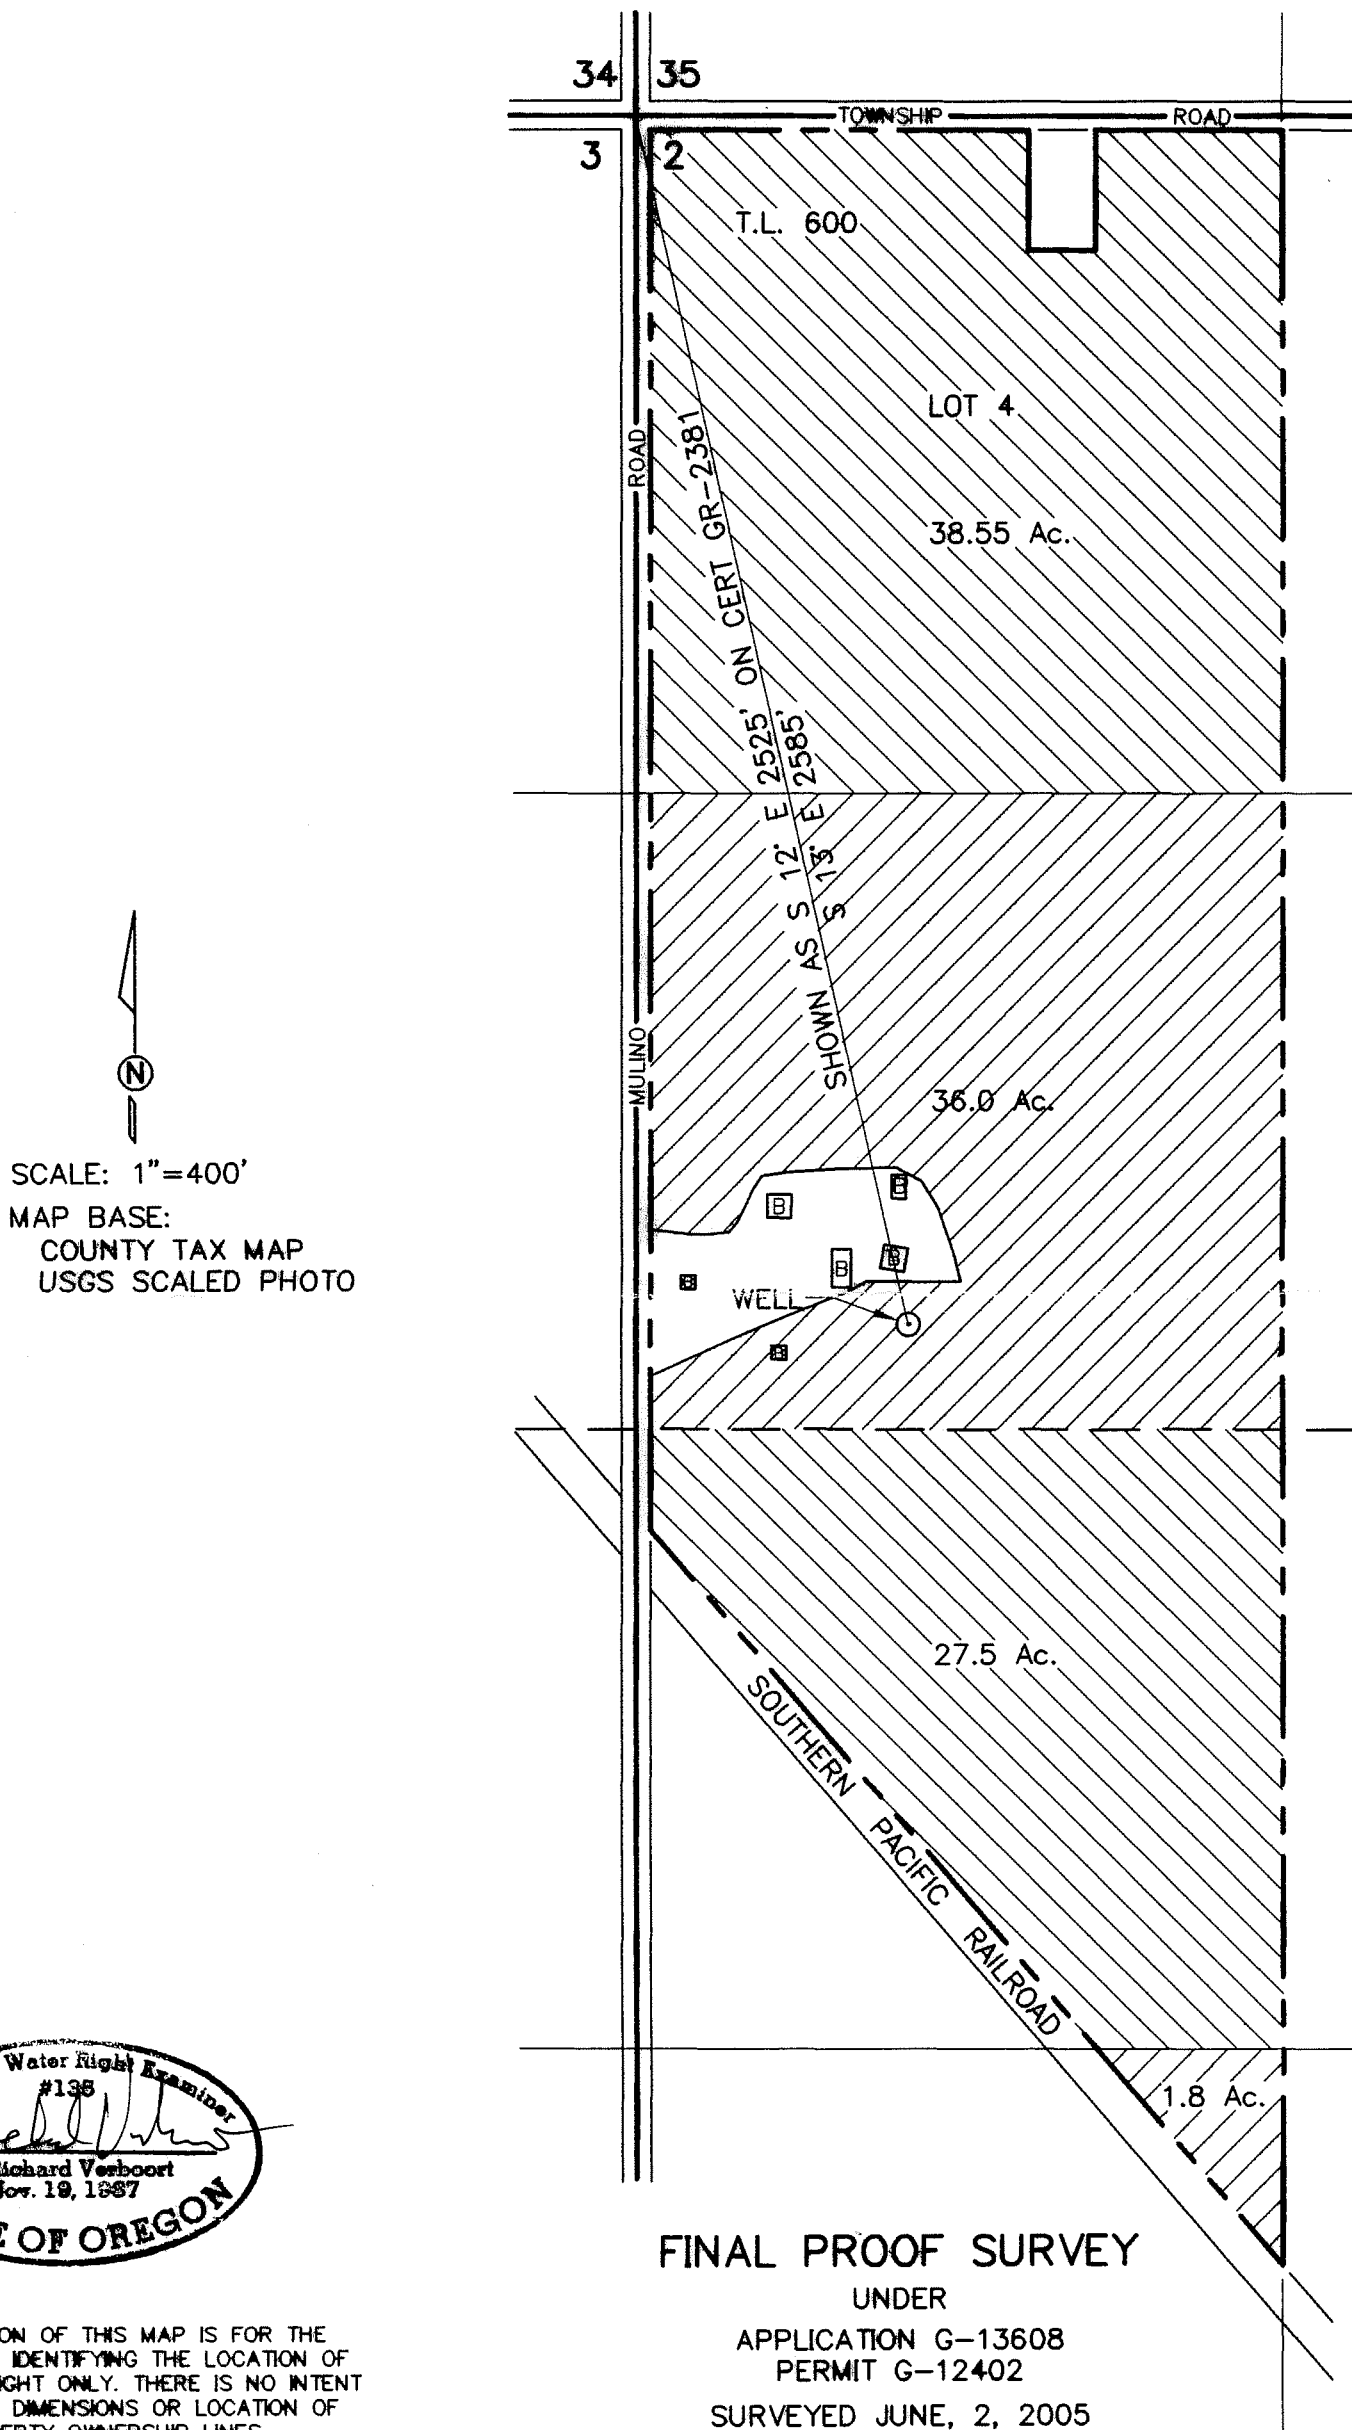

SCALE: 1"=400'
MAP BASE:
COUNTY TAX MAP
USGS SCALED PHOTO

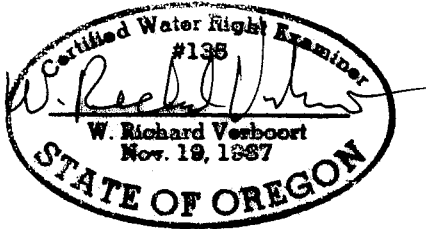

FINAL PROOF SURVEY
UNDER
APPLICATION G-13608
PERMIT G-12402
SURVEYED JUNE, 2, 2005

PREPERATION OF THIS MAP IS FOR THE
PURPOSE OF IDENTIFYING THE LOCATION OF
THE WATER RIGHT ONLY. THERE IS NO INTENT
TO PROVIDE DIMENSIONS OR LOCATION OF
PROPERTY OWNERSHIP LINES.

COBU MAP # 0170



Stuntzner Engineering
& Forestry, LLC

3012-A PACIFIC AVENUE
HALLAD TOWNE SQUARE
FOREST GROVE, OREGON 97116

TEL: (503) 357-5717
FAX: (503) 357-6000
E-MAIL: stuntzner@europa.com

	by	date
designed	WRV	05/17/05
drawn	JER	05/17/05
checked	WRV	05/17/05
drawing no.	305-2-089	
sheet no.	2 / 2	

TERRY L. & SUZANNE C. WEBBER
24464 S. MULINO ROAD
CANBY, OR 97013

RECEIVED

AUG 09 2005

WATER RESOURCES DEPT
SALEM, OREGON