


T.6S. R.1W. Section 24, W.M.

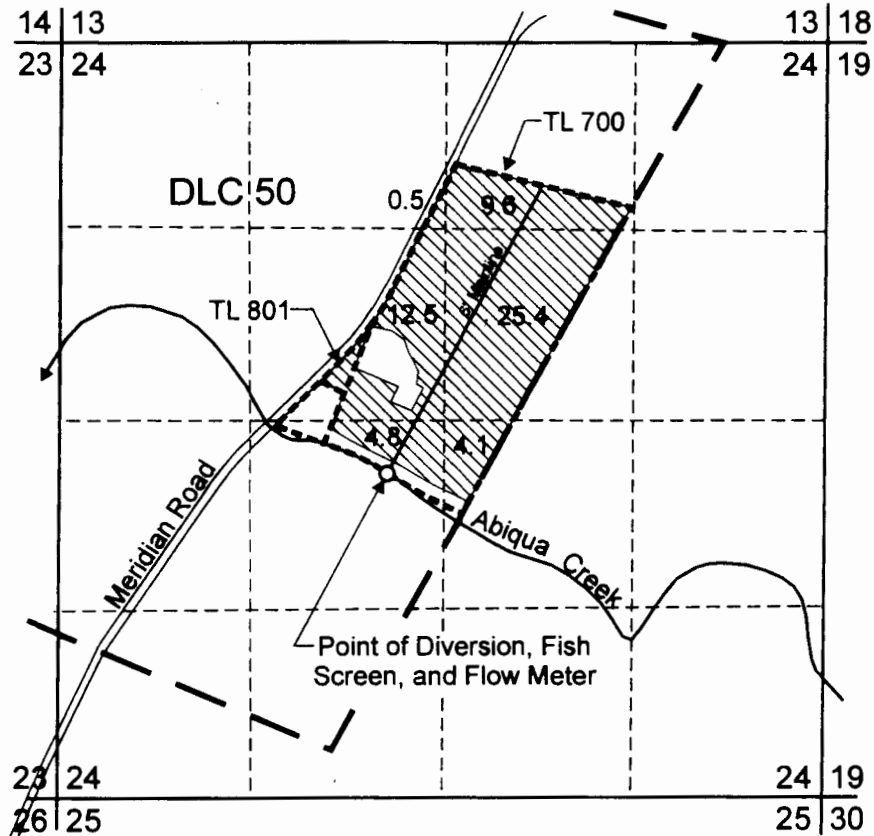

Point of Diversion is located 2,980 feet south and 3,030 feet west from the NE corner, Section 24.


 Area (56.9 Acres) irrigated under Application S-84068, Permit S-53650.

----- Tax lot boundary

RECEIVED

DEC 01 2005

WATER RESOURCES DEPT
SALEM, OREGON

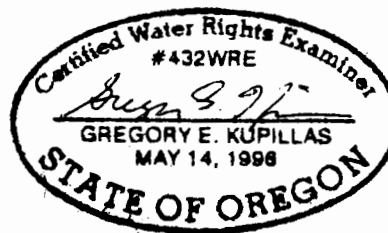

EXPIRATION DATE: 6/30/07

Scale: 1" = 1,320'



0 1,320
Feet

This map was prepared for the purpose of identifying the location of a water right only and is not intended to provide legal dimensions or location of property ownership lines.



Claim of Beneficial Use Map
Application S-84068, Permit S-53650

Pacific Hydro-Geology Inc.

Paul Kraemer

10/2005