

Gerald & Mary Gould

Claim of Beneficial Use

For

Application R 84444

Permit R 12984



T 40 S, R 19 E, W.M.

Section 18

RECEIVED

MAR 21 2005

WATER RESOURCES DEPT
SALEM, OREGON

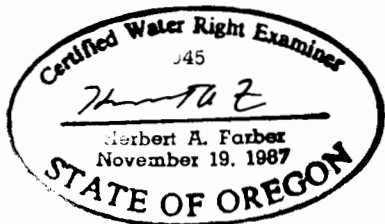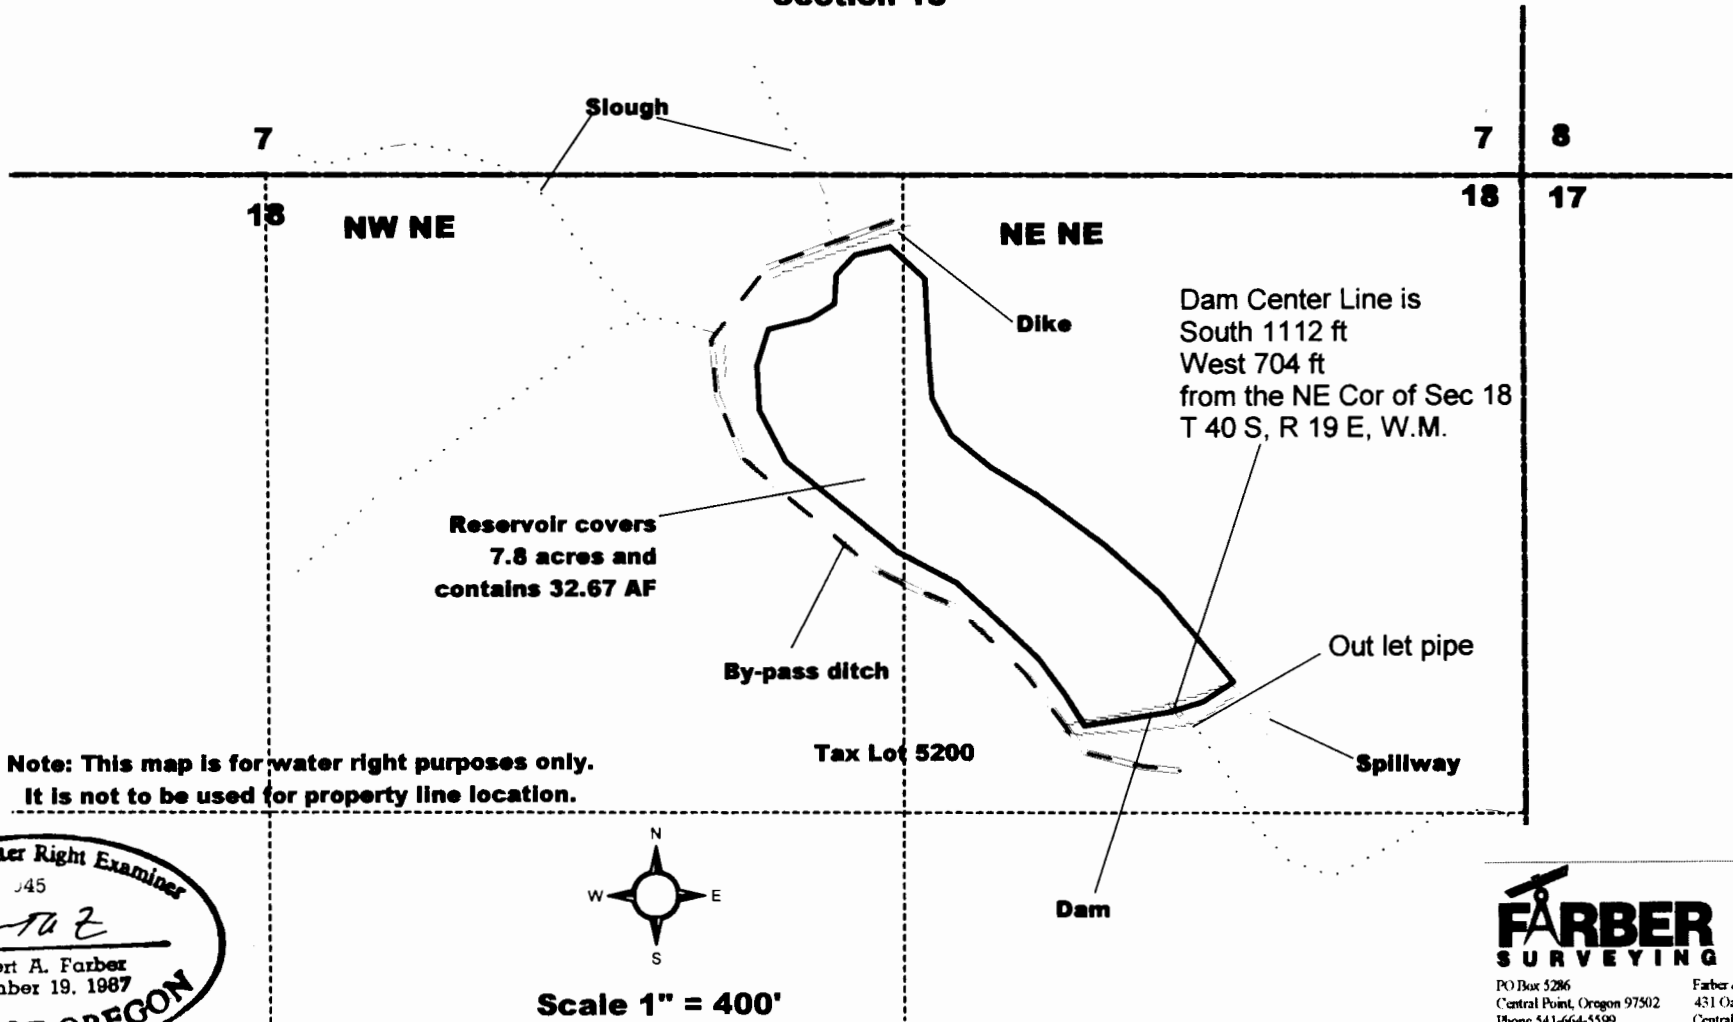

RENEWAL DATE 12-31-2005

FARBER
SURVEYING

PO Box 5286
Central Point, Oregon 97502
Phone 541-664-5599
Fax 541-664-5603
Email hfarber@charter.net

Farber & Sons, Inc.
431 Oak Street
Central Point, Oregon
Tax ID: 95-1057173