


FINAL PROOF SURVEY MAP IN THE NAME OF DONNA DELL SEMAS and ALBERT ANDREW SMITH


APPLICATION S-74037

PERMIT S-53121

SECTIONS 21 & 28, TOWNSHIP 22 SOUTH, RANGE 8 WEST, W.M.

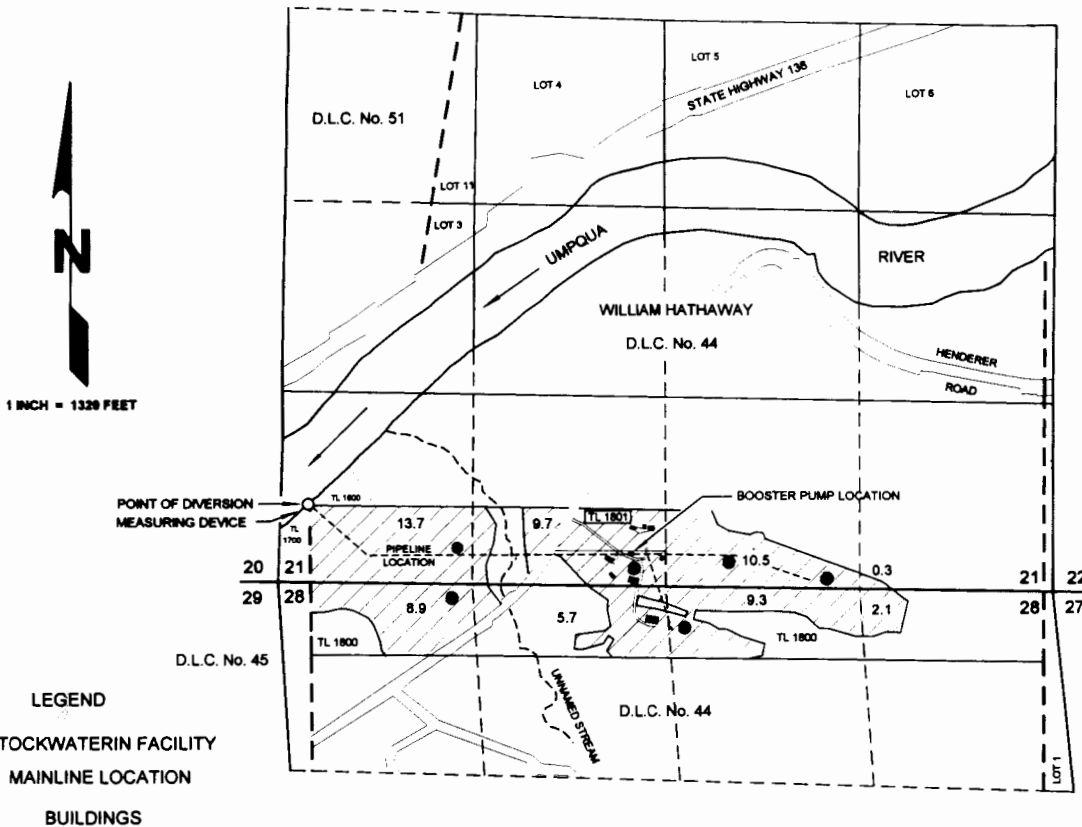

THE POINT OF DIVERSION IS LOCATED 545 FEET NORTH AND 200 FEET EAST FROM THE SOUTHWEST CORNER OF SECTION 21; BEING WITHIN THE SW¹/₄ SW¹/₄ (D.L.C. No. 44) OF SECTION 21, TOWNSHIP 22 SOUTH, RANGE 8 WEST, W.M., DOUGLAS COUNTY.

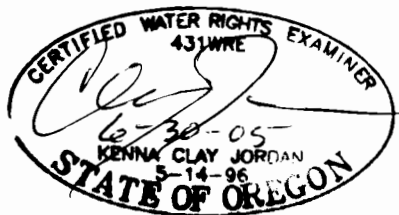

RECEIVED
APR 08 2005
WATER RESOURCES DEPT
SALEM, OREGON

THE PURPOSE OF THIS MAP IS TO IDENTIFY THE LOCATION OF THE WATER RIGHT. IT IS NOT INTENDED TO PROVIDE INFORMATION RELATIVE TO THE LOCATION OF PROPERTY OWNERSHIP BOUNDARY LINES.