


FOR: MICHAEL SHEARER & KAREN MOORE
 BY: DUANE W. KIRBY
 DATE: 10/11/08
 T26S, R3WW.M. SEC 19
 APPLICATION NO.S- 86327
 PERMIT NO. S-54358
 TAX LOT NO. 4 00
 FISH SCREEN IS AT POD

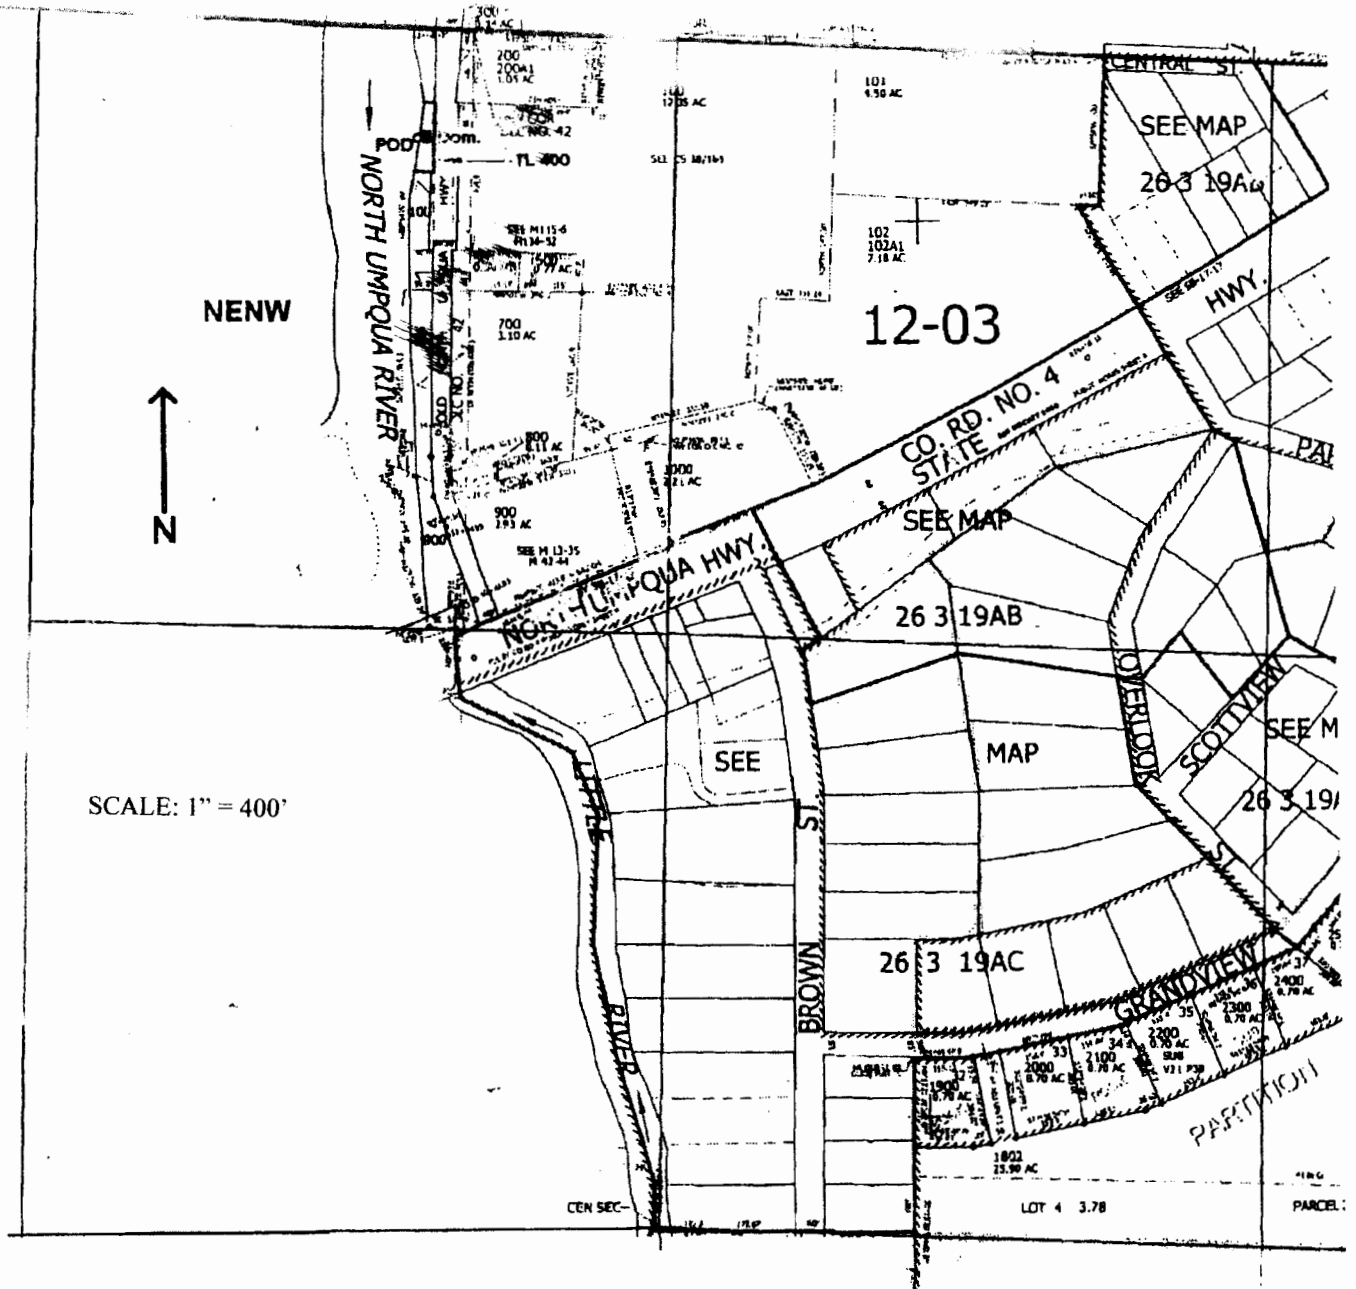

POD is located 240 ft. S. and 566 ft. W. from the N1/4 corner of Sec. 19

THE PURPOSE OF THIS MAP IS TO IDENTIFY THE LOCATION OF THE WATER RIGHT. IT IS NOT INTENDED TO PROVIDE INFORMATION RELATIVE TO THE LOCATION OF PROPERTY OWNERSHIP BOUNDARY LINES.

