


CLAIM OF BENEFICIAL USE  
 FOR: CARL BAUER AND MITSUKO MIYAGI BAUER  
 BY: DUANE W. KIRBY  
 T26S, R6W, SEC 23  
 TAX LOT 1500  
 PERMIT NO S-54295  
 FISH SCREEN IS AT THE POD

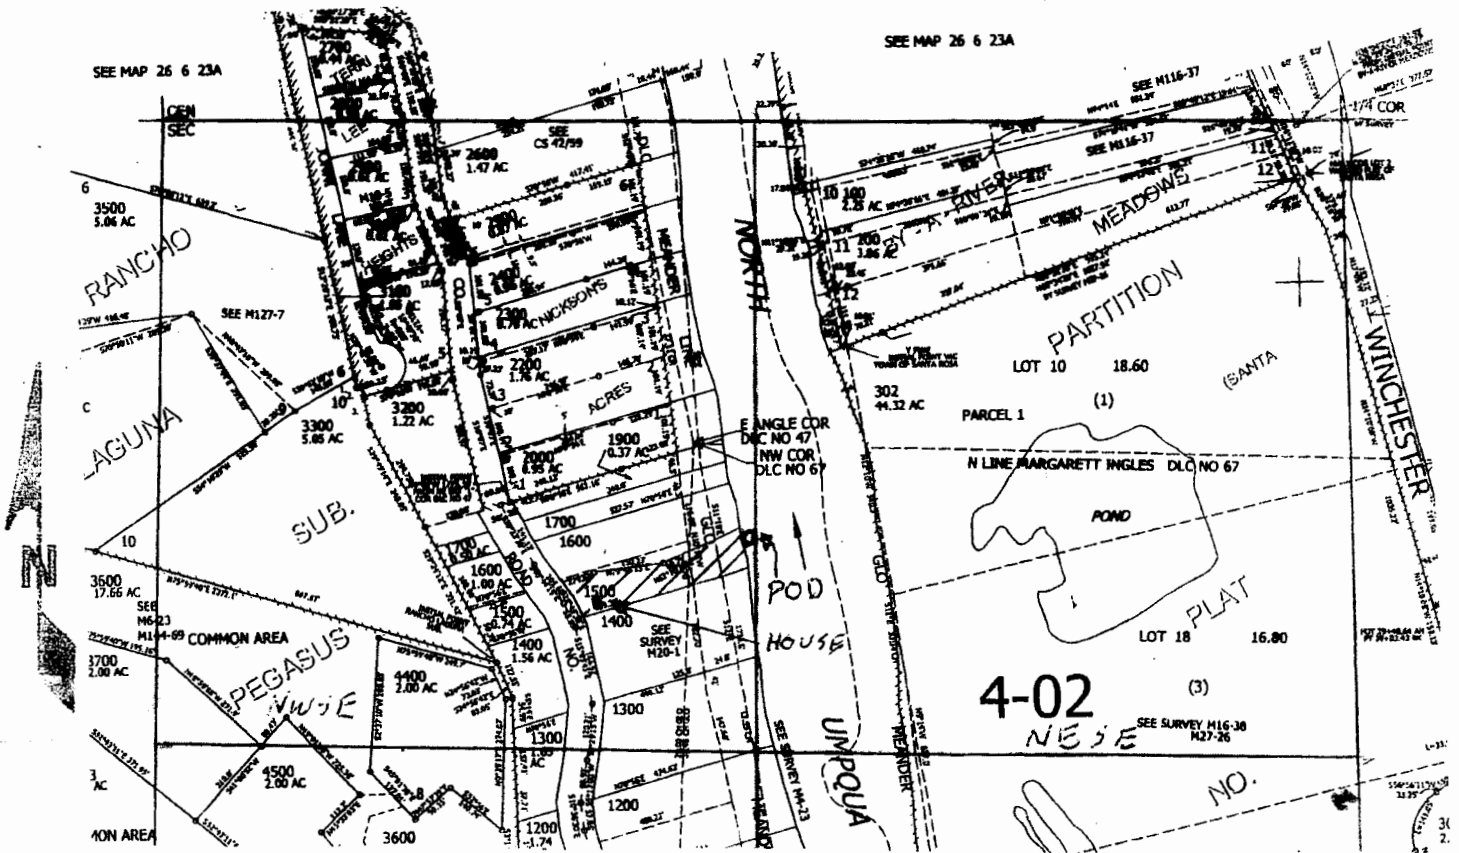

SCALE: 1" = 400'

POD LOCATED 950 FEET SOUTH &  
 1240 FEET EAST OF C 1/4 SEC 23

DOMESTIC USE AND 0.50 ACRE  
 IRRIGATION ON TAX LOT 1500

THE PURPOSE OF THIS MAP IS TO  
 IDENTIFY THE LOCATION OF THE  
 WATER RIGHT. IT IS NOT INTENDED  
 TO PROVIDE INFORMATION RELATIVE  
 TO THE LOCATION OF PROPERTY  
 OWNERSHIP BOUNDARY LINES.

**RECEIVED**

WATER RESOURCES DEPT  
 SALEM, OREGON

