



T.37S.,R.10E.,W.M.

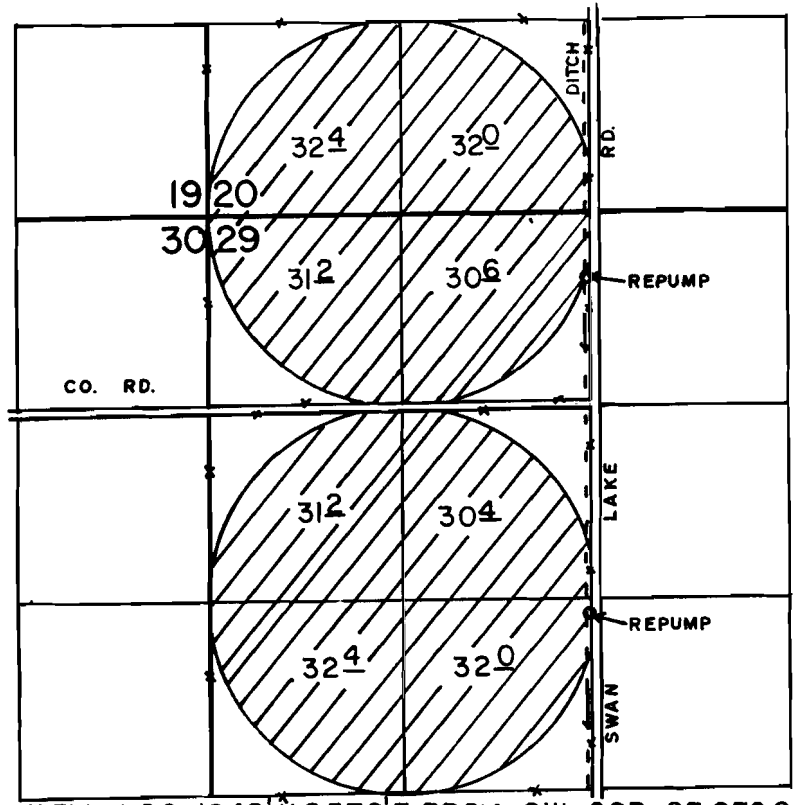

WELL LOC.: 1940' N. & 570' E. FROM SW COR. OF SEC. 8.

SCALE: 1" = 1320'

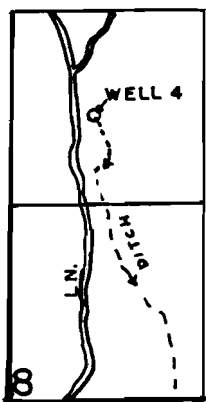

FINAL PROOF SURVEY UNDER

Application No. G-10340 Permit No. G-93.32..
IN NAME OF

JESPERSEN EDGEWOOD INC.

Surveyed MAY 21, 22 1991, by B.W. BISHOP