


14S 5W
 Sec 31
 TL 1000
 1" = 800'

R-84488 Pond
 Located
 315' N &
 1080' W

R-84488 Pond
 Located
 580' N &
 1050' W
 Both from A
 the S.E. of
 corner of
 section 18
 00 1-11-16

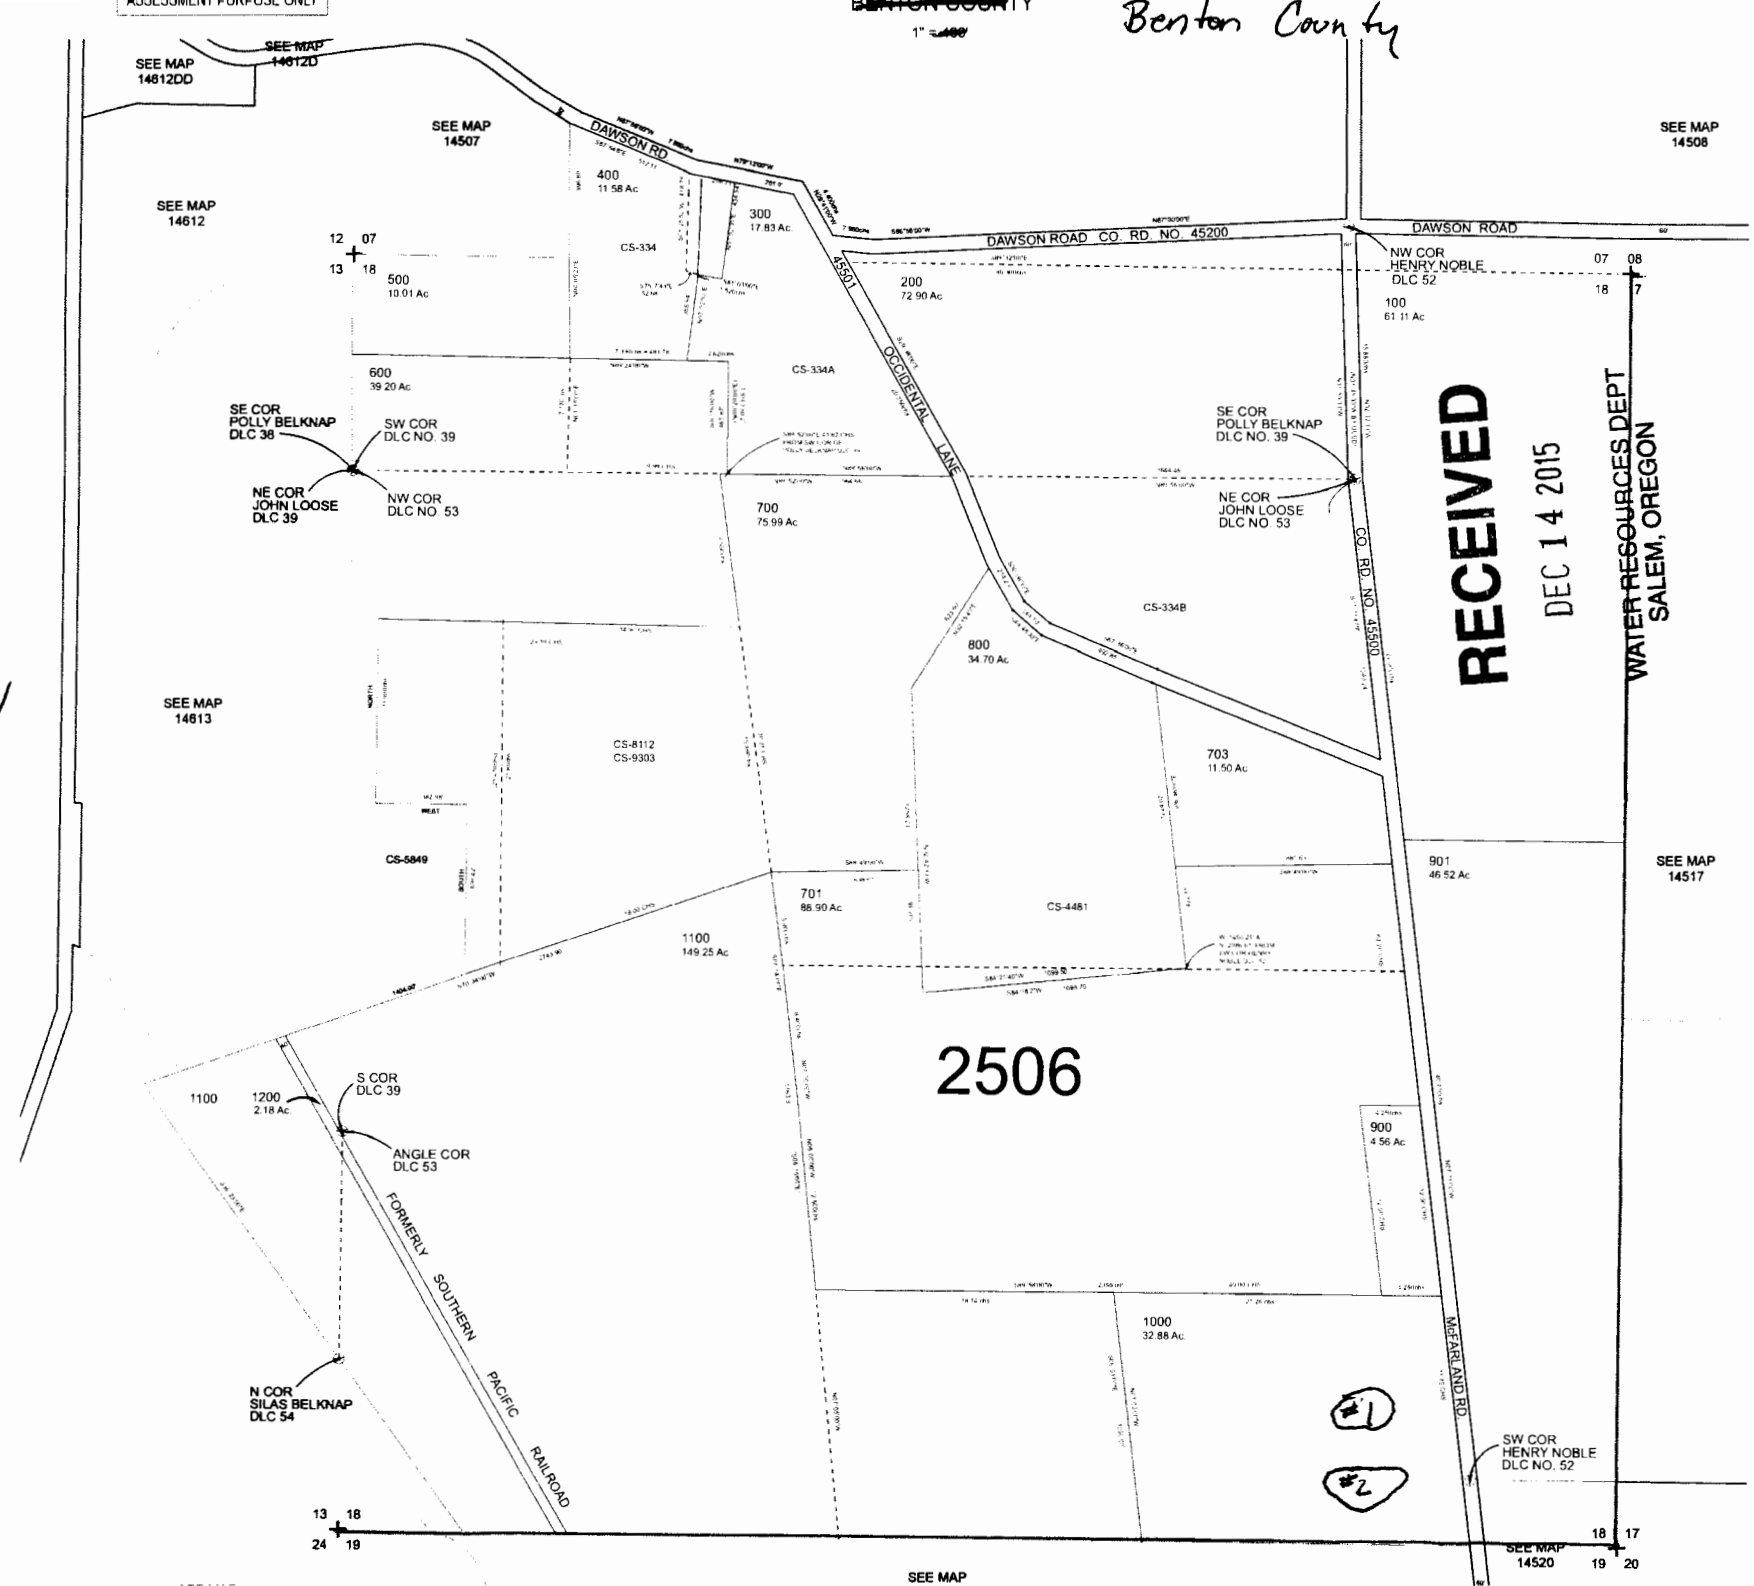

RECEIVED

DEC 14 2015

WATER RESOURCES DEPT
 SALEM, OREGON

SEE MAP