


FINAL PROOF SURVEY MAP IN THE NAME OF LAUREL CREEK ACRES, LLC

**APPLICATION R-72438
S-72439**

**PERMIT R-11755
S-52121**


SECTION 31, TOWNSHIP 29 SOUTH, RANGE 14 WEST, W.M.

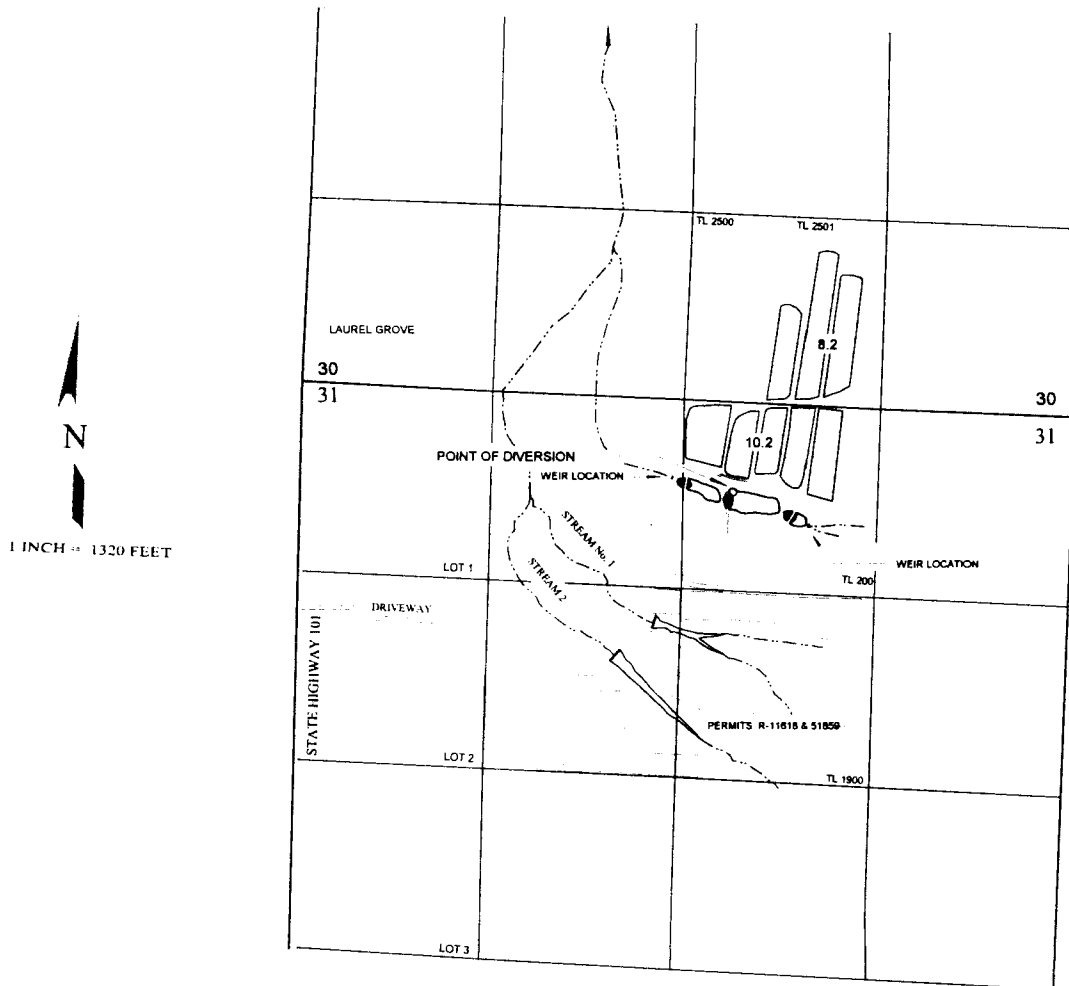

THE POINT OF DIVERSION IS LOCATED 325 FEET EAST AND 640 FEET SOUTH FROM THE NORTH QUARTER CORNER OF SECTION 31; BEING WITHIN THE NW¼ NE¼ OF SECTION 31, TOWNSHIP 29 SOUTH, RANGE 14 WEST, W.M.; COOS COUNTY.

THE DAMS ARE LOCATED AS FOLLOWS:

- NO. 1: 570 FEET SOUTH AND 5 FEET EAST;
 - NO. 2: 675 FEET SOUTH AND 295 FEET EAST; AND
 - NO. 3: 800 FEET SOUTH AND 720 FEET EAST; ALL
- FROM THE NORTH QUARTER CORNER OF SECTION 31; BEING WITHIN THE NW¼ NE¼ OF SECTION 31, TOWNSHIP 29 SOUTH, RANGE 14 WEST, W.M.; COOS COUNTY.

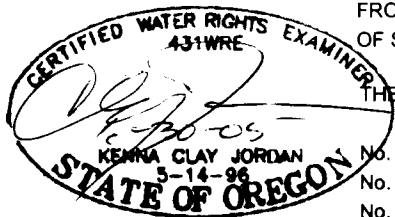

RECEIVED

SEP 11 2006

WATER RESOURCES DEPT
SALEM OREGON