


T. 33S., R. 10 & 11W., W.M.

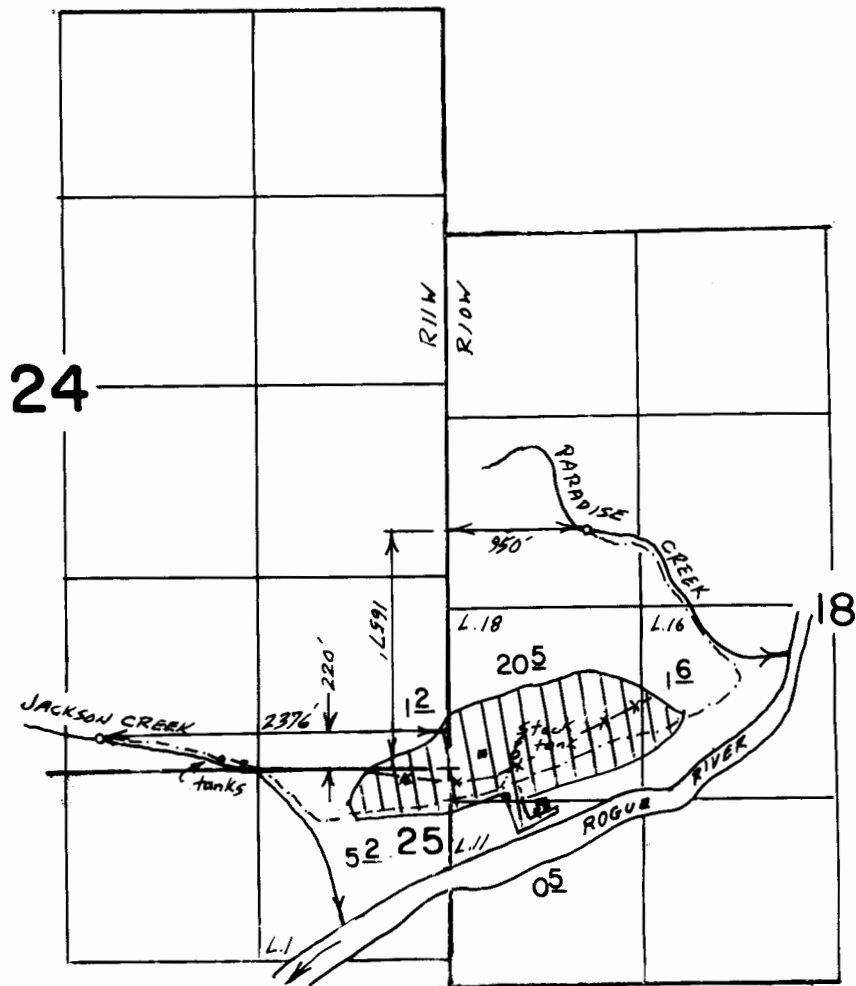

Scale 1" = 1320'

FINAL PROOF SURVEY UNDER

Application No. 57186. Permit No. 52720....
IN NAME OF

COURT. A. and DAWN BOICE.....

Surveyed July 31, 1999, by BS DeHaas.....