

FINAL PROOF SURVEY

SITUATED IN THE E1/2 SW1/4 AND W1/2 SE1/4 OF SECTION 30, THE
NW1/4 NE1/4 AND NW1/4 OF SECTION 31, T35S, R11EWM,
KLAMATH COUNTY, OREGON
AUGUST, 2006

MAP PREPARED FOR


TOM GRIFFITH

MAP PREPARED FROM

ASSESSORS MAPS
AERIAL PHOTO
FIELD INSPECTION

APPLICATION #G-14348

PERMIT #G-13162

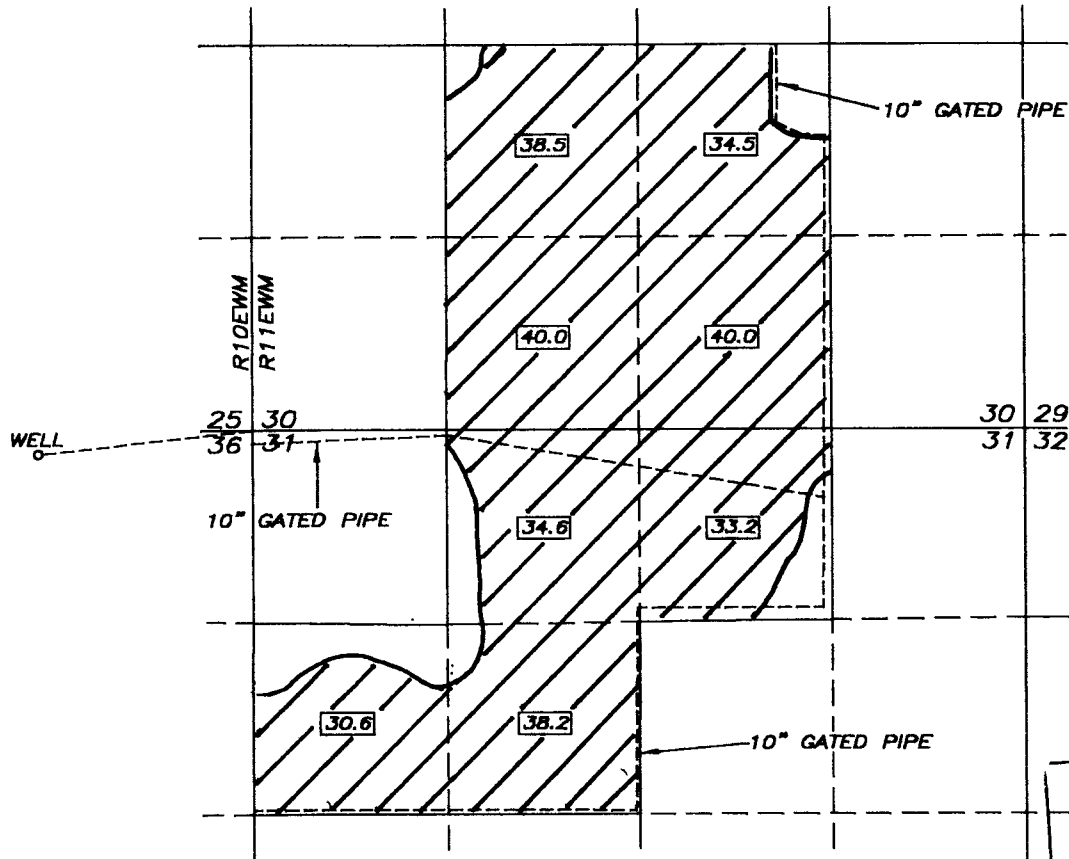

TOTAL AREA

--289.6 ACRES--

WELL IS 1470' WEST AND 160' SOUTH
OF THE NORTHEAST CORNER OF SECTION
36.




LANDS WITHIN THIS APPLICATION

THE PURPOSE OF THIS MAP IS TO IDENTIFY
THE LOCATION OF THE WATER RIGHT. IT IS NOT
INTENDED TO PROVIDE INFORMATION RELATIVE TO
THE LOCATION OF PROPERTY OWNERSHIP BOUNDARY
LINES.

RECEIVED

AUG 14 2006

WATER RESOURCES DEPT
SALEM, OREGON

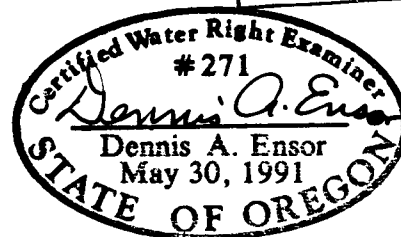

EXPIRES: 12/31/07

TRU-LINE SURVEYING, INC.
2333 SUMMERS LANE
KLAMATH FALLS, OREGON 97603