


TOWNSHIP 14 SOUTH, RANGE 11 EAST, W.M.

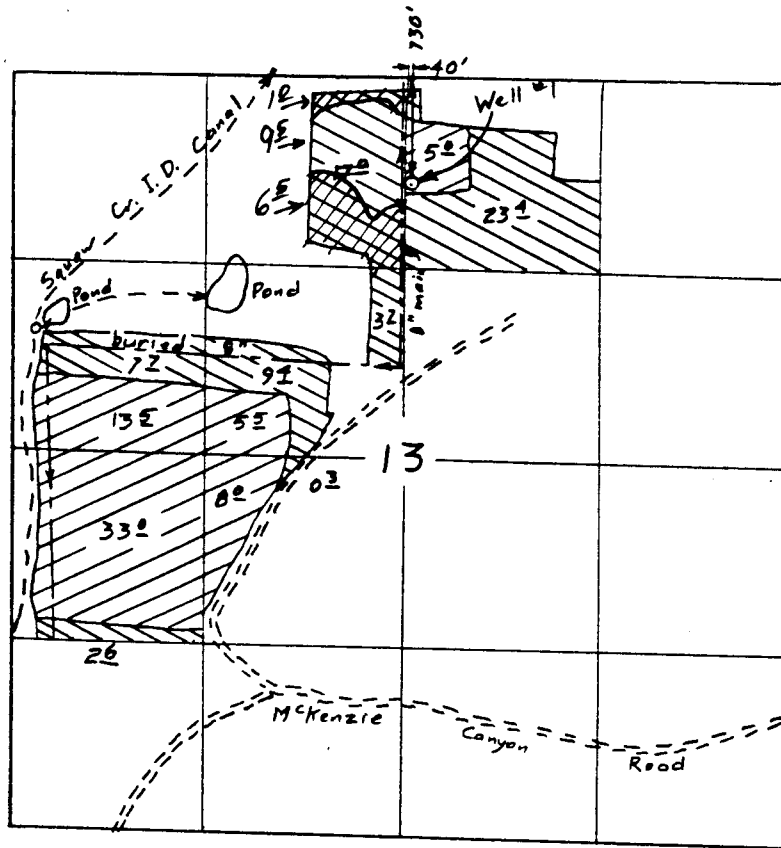

Scale 1" = 1320'




- Primary 56.1 acres
- Supplemental ~~65.2~~ 72.5 acres

Surveyed Sep 5, 2000

Claim of Beneficial Use Map
for

DAVID & RUTH PARKS

App G-13029
Per G-12471

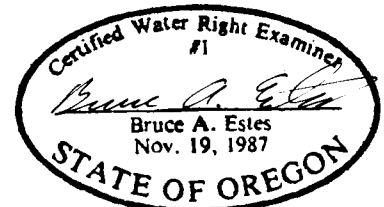

Renewal Dec 31, 2001

Map updated by WRD
to identify additional
Supplemental acres. JC/WRD
6/22/15

This map is for the purpose of
locating a water right only
and has no intent to provide
legal dimensions or the location
of property lines.

ESTES SURVEYS

PO Box 17519 60382 Arnold Rd
Salem, OR 97305-7519 Bend, OR 97702
(503) 585-7593 (541) 382-7391