


CLAIM OF BENEFICIAL USE
 FOR STEPHEN SHAW AND KAY TANNER
 BY: DUANE W. KIRBY
 T26S, R5W, SEC. 14 WM
 PERMIT NO S-54280
 TAX LOT 1000
 FISH SCREEN IS AT THE POD.
 SCALE: 1" = 400'

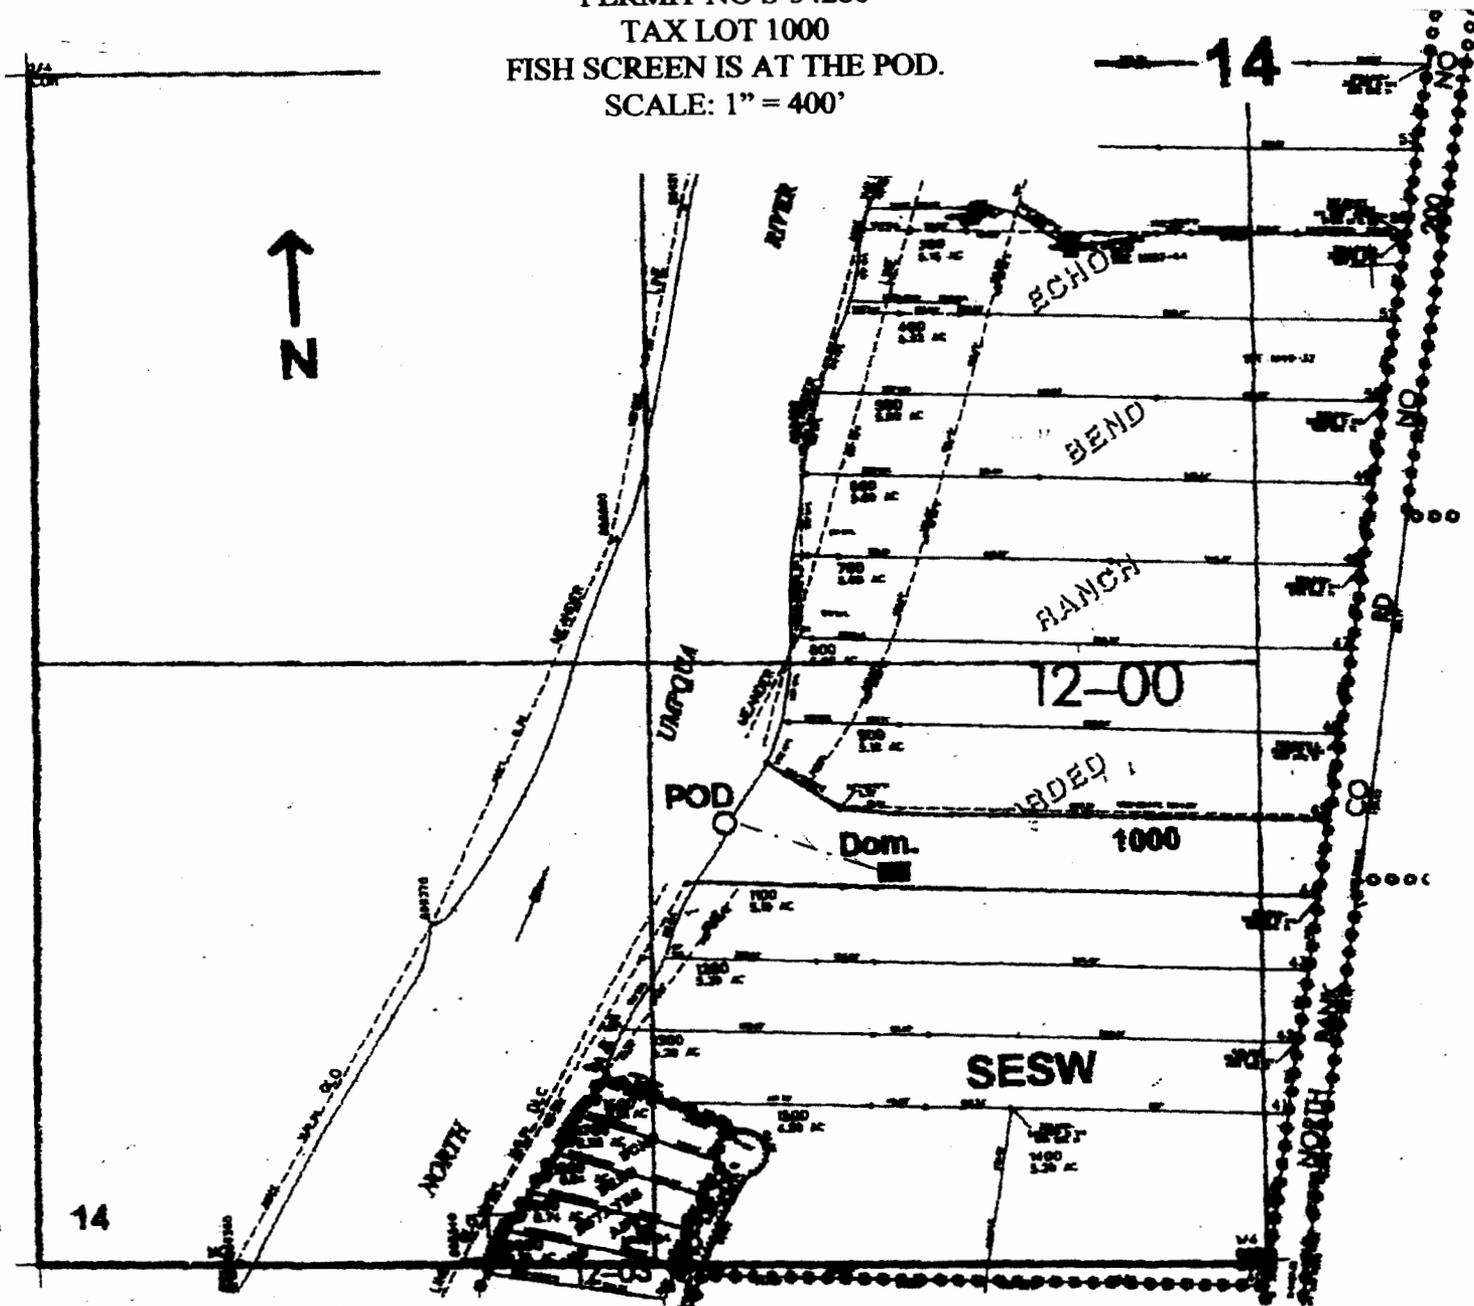

POD is located 970 ft. N. and 1150 ft. W. from the S1/4 corner of Sec. 14

THE PURPOSE OF THIS MAP IS TO IDENTIFY THE LOCATION OF THE WATER RIGHT. IT IS NOT INTENDED TO PROVIDE INFORMATION RELATIVE TO THE LOCATION OF PROPERTY OWNERSHIP BOUNDARY LINES.

RECEIVED

JUN 02 2009

WATER RESOURCES DEPT
 SALEM, OREGON

