RECEIVED
WATER RESOURCES DEPT
SALEM, OR

T8S, R10W., W.M.
NE1/4 – NW1/4 SECTION 16
LINCOLN COUNTY, OREGON
Scale: 1 inch = 400 feet

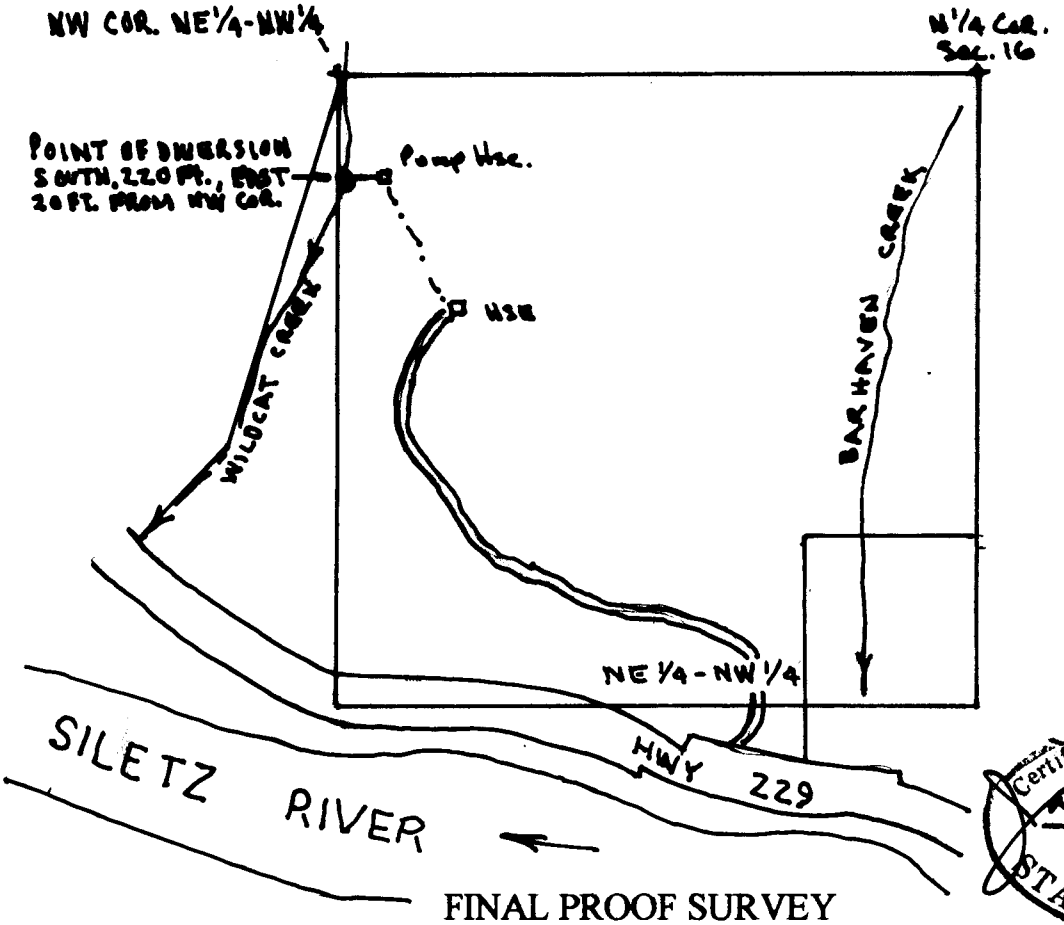

Certified Water Right Examiner
#037 WRE
James M. Denison
Nov. 19, 1987
STATE OF OREGON

FINAL PROOF SURVEY
UNDER

APPLICATION # S-84204 PERMIT # 53691

IN THE NAME OF

Dorsey & Yvonne Elliot

SURVEYED: May 5, 2001 BY: James M. Denison

THIS MAP PREPARED SOLEY FOR THE PURPOSE OF SHOWING LOCATION OF A WATER RIGHT, AND IS NOT INTENDED FOR USE TO PROVIDE DIMENSIONS OR LOCATION OF PROPERTY OWNERSHIP LINES.