


CLAIM OF BENEFICIAL USE MAP FOR PERMIT R-14243

T. 35 S., R. 6 W., W. M., JOSEPHINE COUNTY

Section 2 SE1/4 SE1/4

August 15, 2009

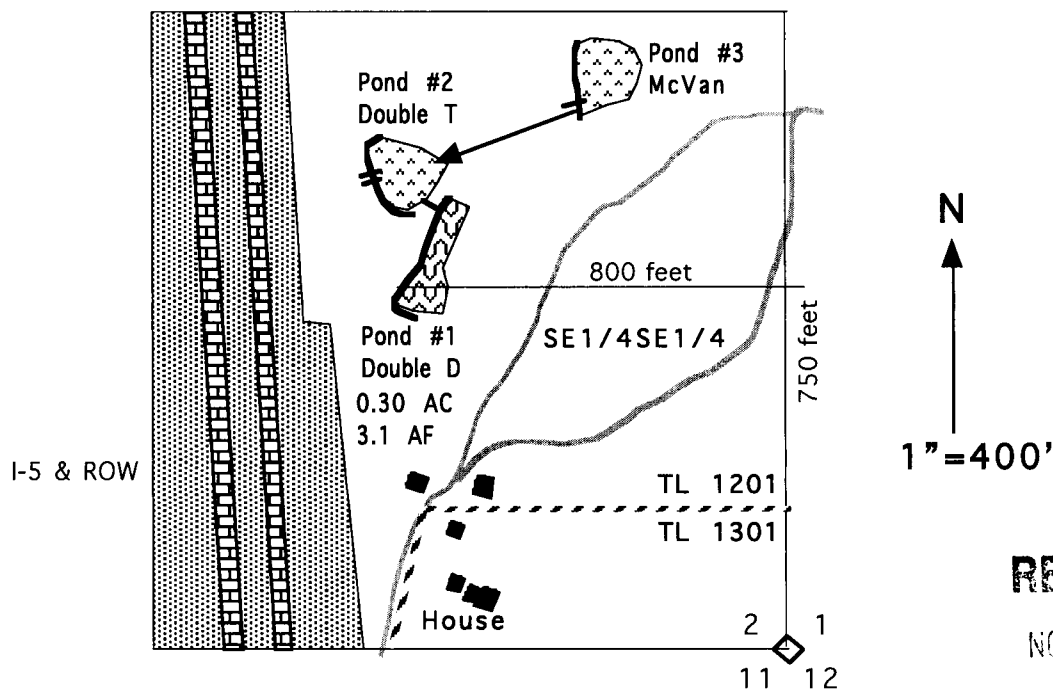

RECEIVED

NOV 02 2009

WATER RESOURCES DEPT
SALEM, OREGON

 Pond #1 (Double D) storing 3.1 acre-feet of water for multiple purpose uses in a reservoir constructed under Application R-86287 and Permit R-14243 with a priority of May 2, 2005.

 Dams

 15 inch diameter spillway culverts.

 Pond #2 and Pond #3.

 Gravel roads

 Buildings

 Buried 3 inch diameter PVC pipe.



This map was drawn by Gordon R. Lyford for Brad Vandehey to support his Claim of Beneficial Use to store water for multiple purpose uses. Brad Vandehey owns tax lots 1201 and 1301.

This map was prepared for the purposes of identifying the location of water rights only and is not intended to provide legal dimensions or the location of property ownership lines.