

T.35S.,R.6W.,W.M.
SECTION 2 SE 1/4, SE 1/4


THIS MAP IS FOR THE PURPOSE OF
IDENTIFYING THE LOCATION OF THE
WATER RIGHT ONLY AND IS NOT IN-
TENDED TO PROVIDE LEGAL DIMEN-
SIONS OR LOCATIONS OF PROPERTY
OWNERSHIP LINES.

WELL 2 IS 1080' N
630' W
FROM SE COR. SEC. 2

SHOWS LOCATION OF BURIED
P.V.C. IRRIGATION PIPELINE

SCALE 1"= 400'

S = SUMP

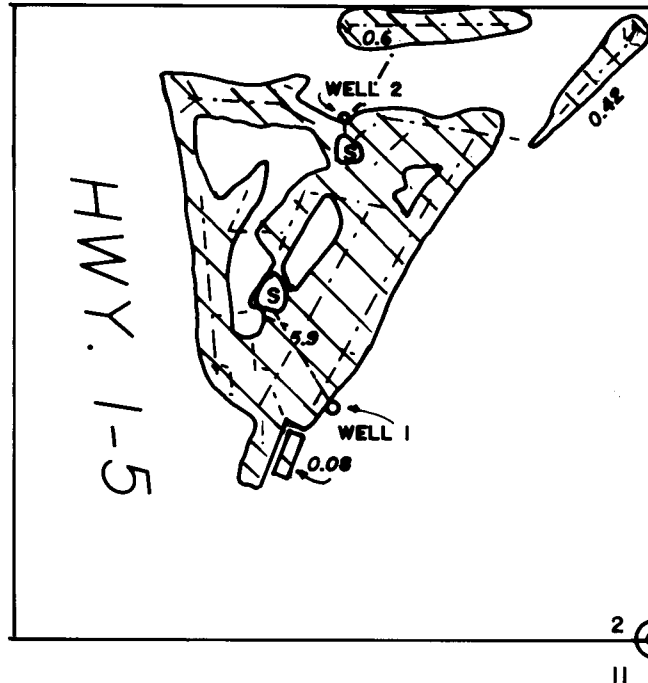

WELL 1 IS 490' N
670' W
FROM SE COR. SEC. 2

RECEIVED

SEP 23 1993

WATER RESOURCES DEPT
SALEM, OREGON

FINAL PROOF SURVEY

UNDER

APPLICATION NO. G-11687 PERMIT NO. G-10966

IN NAME OF

DAVE SNOOK

SURVEYED SEPTEMBER 20, 1993

BY JONATHAN C. SPERO W.R.E. #123

