


POINT OF DIVERSION  
 Point of Diversion is 2,190 ft. North & 700 West from the southeast corner of Section 14.  
 This P.O.D. also is the existing used P.O.D. of Permit No. 37316 (Glen W. Weeks) & Permit No. 43484 (Wayne & Carole Brady).

NOTE:  
 This map is for purposes of establishing a water right. It is not a survey map.

FISH SCREEN IS AT THE POD  
 METER IS 30 FEET FROM THE POD  
 CLAIM OF BENEFICIAL USE

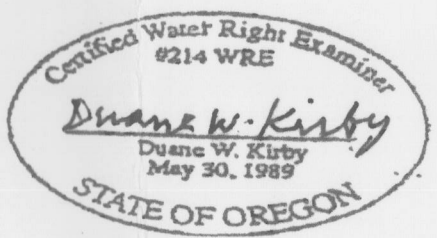

R. D. Foster DLC No. 43

PERMIT TO APPROPRIATE SURFACE WATER FROM THE R. D. FOSTER D.L.C. NO. 43 AND THE W 1/2 SW 1/4 OF SECTION 13 AND THE E 1/2 SE 1/4 OF SECTION 14 IN T 26 S, R 4 W, W. M., DOUGLAS COUNTY, OREGON TAX LOT 400

Application No. 72573  
 Permit No. 51806

For: Mary Connine Hyatt  
 2231 Wild River Drive  
 Roseburg, Oregon 97470

BY: DUANE W. KIRBY  
 8087 LOOKINGGLASS,  
 ROSEBURG, OREGON 97471

COBU MAP #0373

RECEIVED  
 SEP 03 2008  
 WATER RESOURCES DEPT  
 SALEM, OREGON

SCALE: 1" = 200 FT