

CLAIM OF BENEFICIAL USE & FINAL PROOF MAP
 LOCATED IN THE NW¼ SE¼ OF SECTION 8,
 TOWNSHIP 28 SOUTH, RANGE 13 WEST, W.M.
 APPLICATION S-87045, PERMIT 54538
 COOS COUNTY, OREGON

1" = 400 FEET

PREPARED FOR: BARRY HEATH
 PREPARED BY: DENNIS GOUDE
 DATE PREPARED: MAY 28, 2009


RECEIVED



EXPIRES 12/31/2009

WATER SOURCE
 SA FROM OREGON

TROJAN UV FILTRATION SYSTEM
 AND SENSUS FLOW METER
 1 INCH DIAMETER PVC PIPE

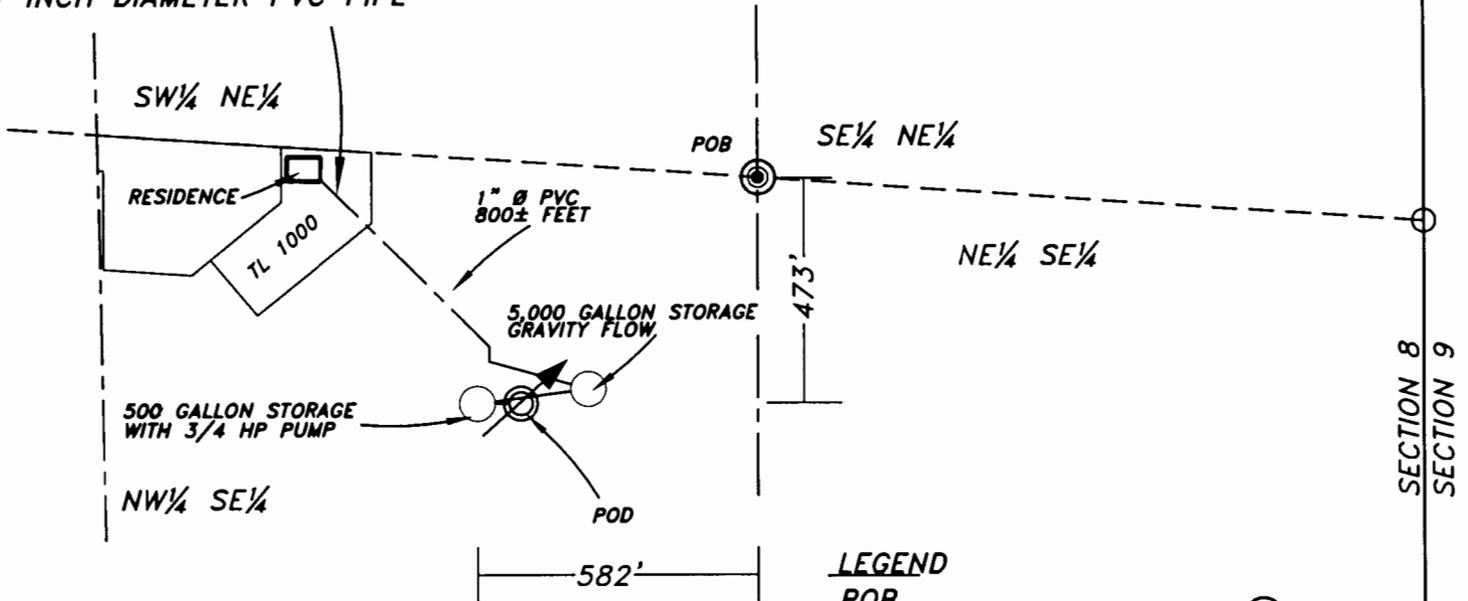

LEGEND

- POB
(POINT OF BEGINNING)
- POD
(POINT OF DIVERSION)
- RESIDENCE
(NOT TO SCALE)

NOTE:
 THE POINT OF DIVERSION IS AN INSPIRING CATCH BASIN
 LOCATED 473 FEET SOUTH AND 582 FEET WEST FROM
 THE CENTER-EAST 1/16 CORNER OF SECTION 8, TOWNSHIP
 28 SOUTH, RANGE 13 WEST.

EXAMINERS DISCLAIMER STATEMENT

The preparation of this map was for the purpose of
 identifying the location of the Water Right only and
 has no intent to provide dimensions or location of
 property ownership lines.

**Stuntzner Engineering
 & Forestry, L.L.C.**
 ENGINEERING • LAND SURVEYING • FORESTRY
 PLANNING • WATER RIGHTS
 705 South 4th St. Phone: (541) 267-2872
 Post Office Box 118 Coos Bay, Oregon 97420 Fax: (541) 267-0588