


FIVE

T4S R1W W.M.
T5S R1W W.M.


water
SALES

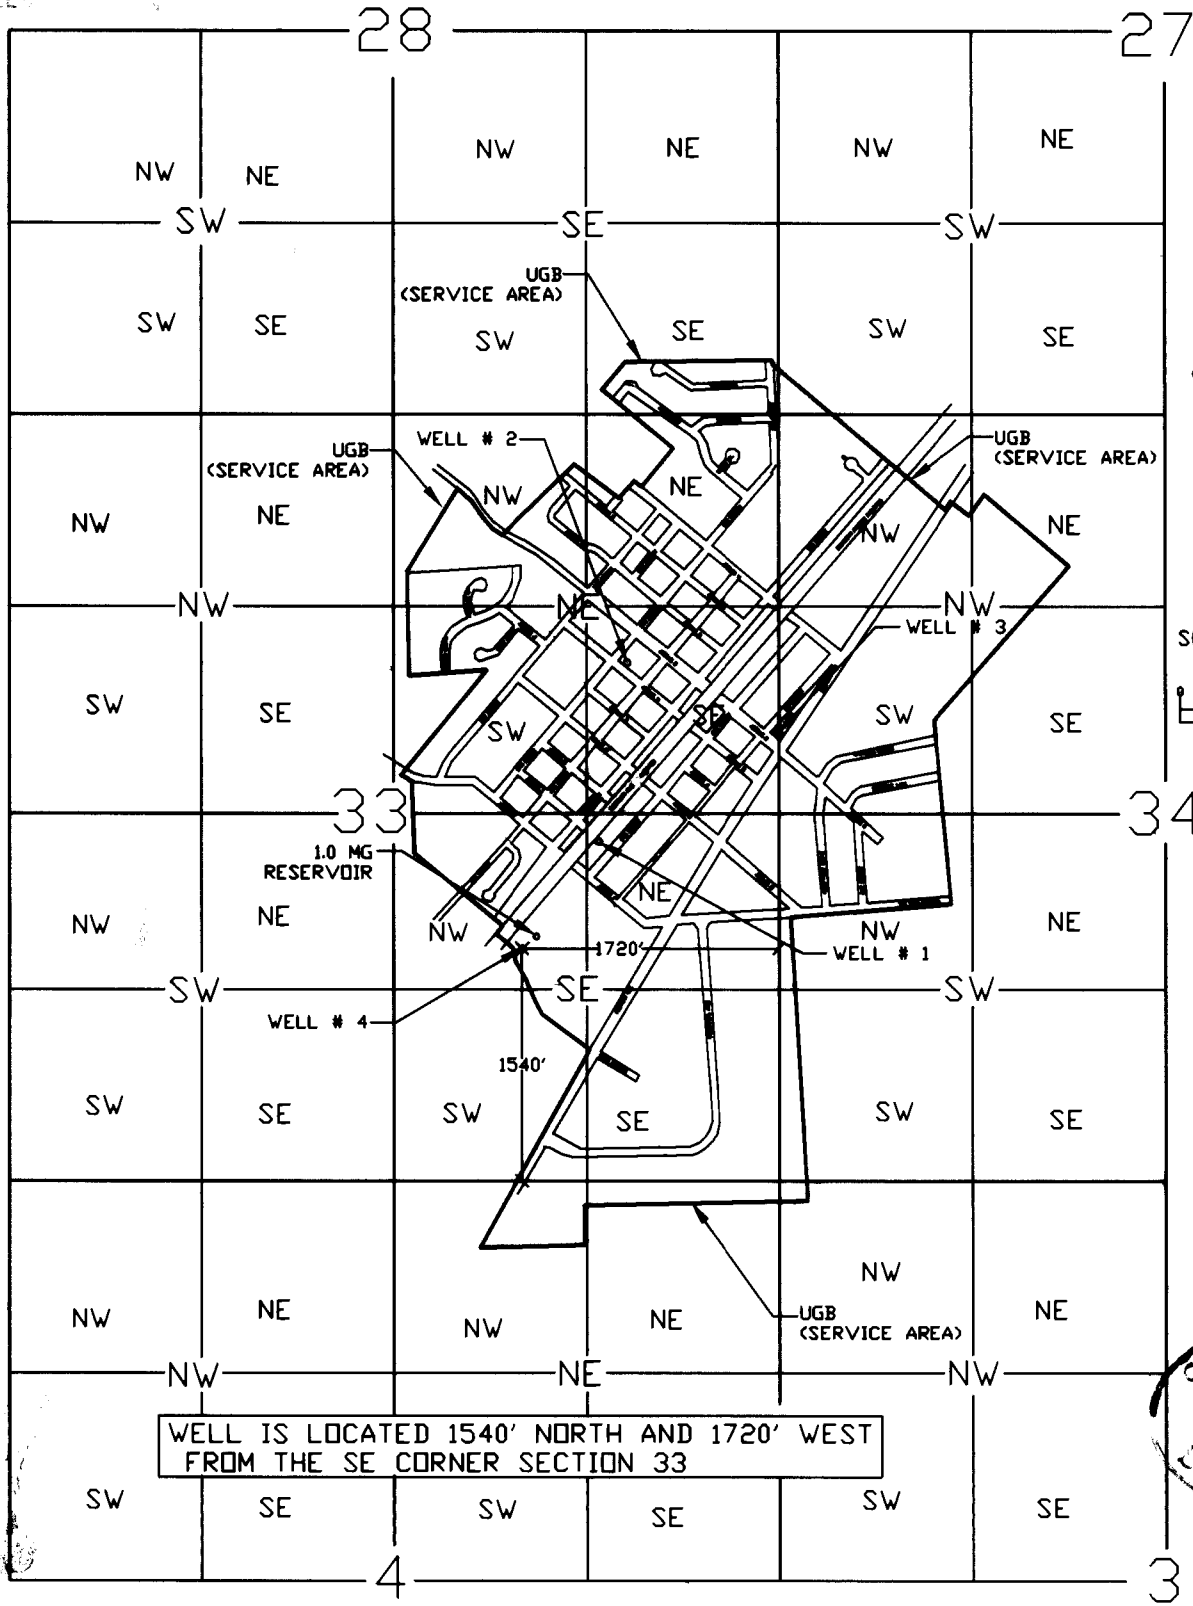

SCALE: 1" = 1320'



WELL IS LOCATED 1540' NORTH AND 1720' WEST
FROM THE SE CORNER SECTION 33

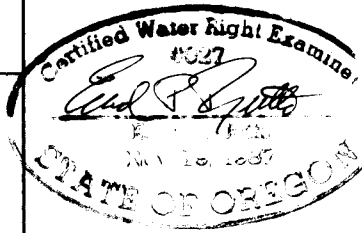

THIS MAP WAS PREPARED FOR THE PURPOSE OF IDENTIFYING THE
LOCATION OF A WATER RIGHT ONLY AND IS NOT INTENDED TO
PROVIDE LEGAL DIMENSIONS OR LOCATION OF PROPERTY OWNERSHIP
LINES.

FINAL PROOF SURVEY
APPLICATION #: G-14954 PERMIT #: G-13857
CITY OF HUBBARD