

COBU MAP #

0371

S27
S34

465'
FD BRASS CAP - 1/4 COR

GOV'T LOT 7
NE 1/4, NW 1/4

GOV'T LOT 6

NW 1/4, NE1/4

SILTCOOS LAKE

POINT OF DIVERSION & FISH SCREEN
1009 FEET SOUTH AND 465 FEET
EAST OF THE 1/4 COR S 27/ S 34

METER
DOCK
PIPE
RESIDENCE

LOT 21, BLK 9
'WESTLAKE'

GOV'T LOT 1
SE 1/4, NW 1/4

GOV'T LOT 3
SW 1/4, NE1/4

34

THIS MAP IS FOR THE PURPOSE
OF IDENTIFYING THE LOCATION
OF THE WATER RIGHT ONLY.
THERE IS NO INTENT TO PROVIDE
DIMENSIONS OR LOCATION OF
PROPERTY OWNERSHIP LINES.


FINAL PROOF SURVEY CLAIM OF BENEFICIAL USE WATER RIGHTS MAP MID COAST BASIN UNDER

PERMIT 53968 APPLICATION NO S-85575

MAP 19-12-34-2-1, T.L. 4200
NW 1/4, NE 1/4, SEC 34, T19S, R12W, W.M.
LANE COUNTY, OREGON

FOR: EUGENE AND MYRTLE STROUD
P.O. BOX 2780
FLORENCE, OREGON 97439

PREPARED BY: WOBBE & ASSOCIATES, INC.
510 KINGWOOD ST. / P.O. BOX 3093
FLORENCE, OR 97439
DATE: JUNE 24, 2008

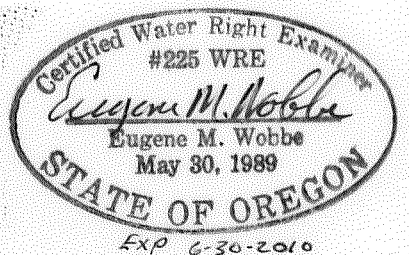

RECEIVED

AUG 21 2008

WATER RESOURCES DEPT
SALEM, OREGON



1"=400'



0371