

Final Proof Survey
under Permit #G12882
and Application #G14229
in the name of
Stanley P. Woodworth

T24S, R32E, Sec. 9, W1/2NE1/4
& Gov't Lots 1 & 2, W.M.
Harney County, Oregon
Tax Lot 2900 & 2901
Tax Lot Map 24S 32E



Basis of Bearing:
GPS observation
SCALE: 1 inch = 400 feet
Surveyed May and August 2008

For the purposes of this map Gov't
Lots 1 and 2 are shown as aliquot
parts; NENE and SENE.

All aliquot parts are projected from
the CW1/16 of section 10 which was
occupied with GPS for the purposes of this
this survey.

This map is for the purpose of identifying
the location of the water right only, and is
not intended to provide legal dimensions
or location of property ownership lines.

RECEIVED
SEP 23 2008
WATER RESOURCES DEPT
SALEM, OREGON

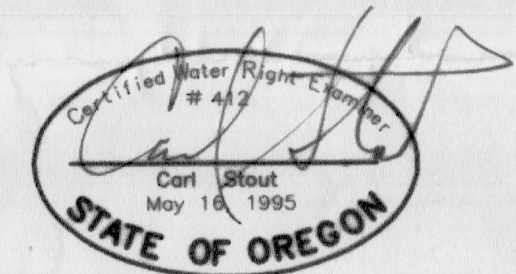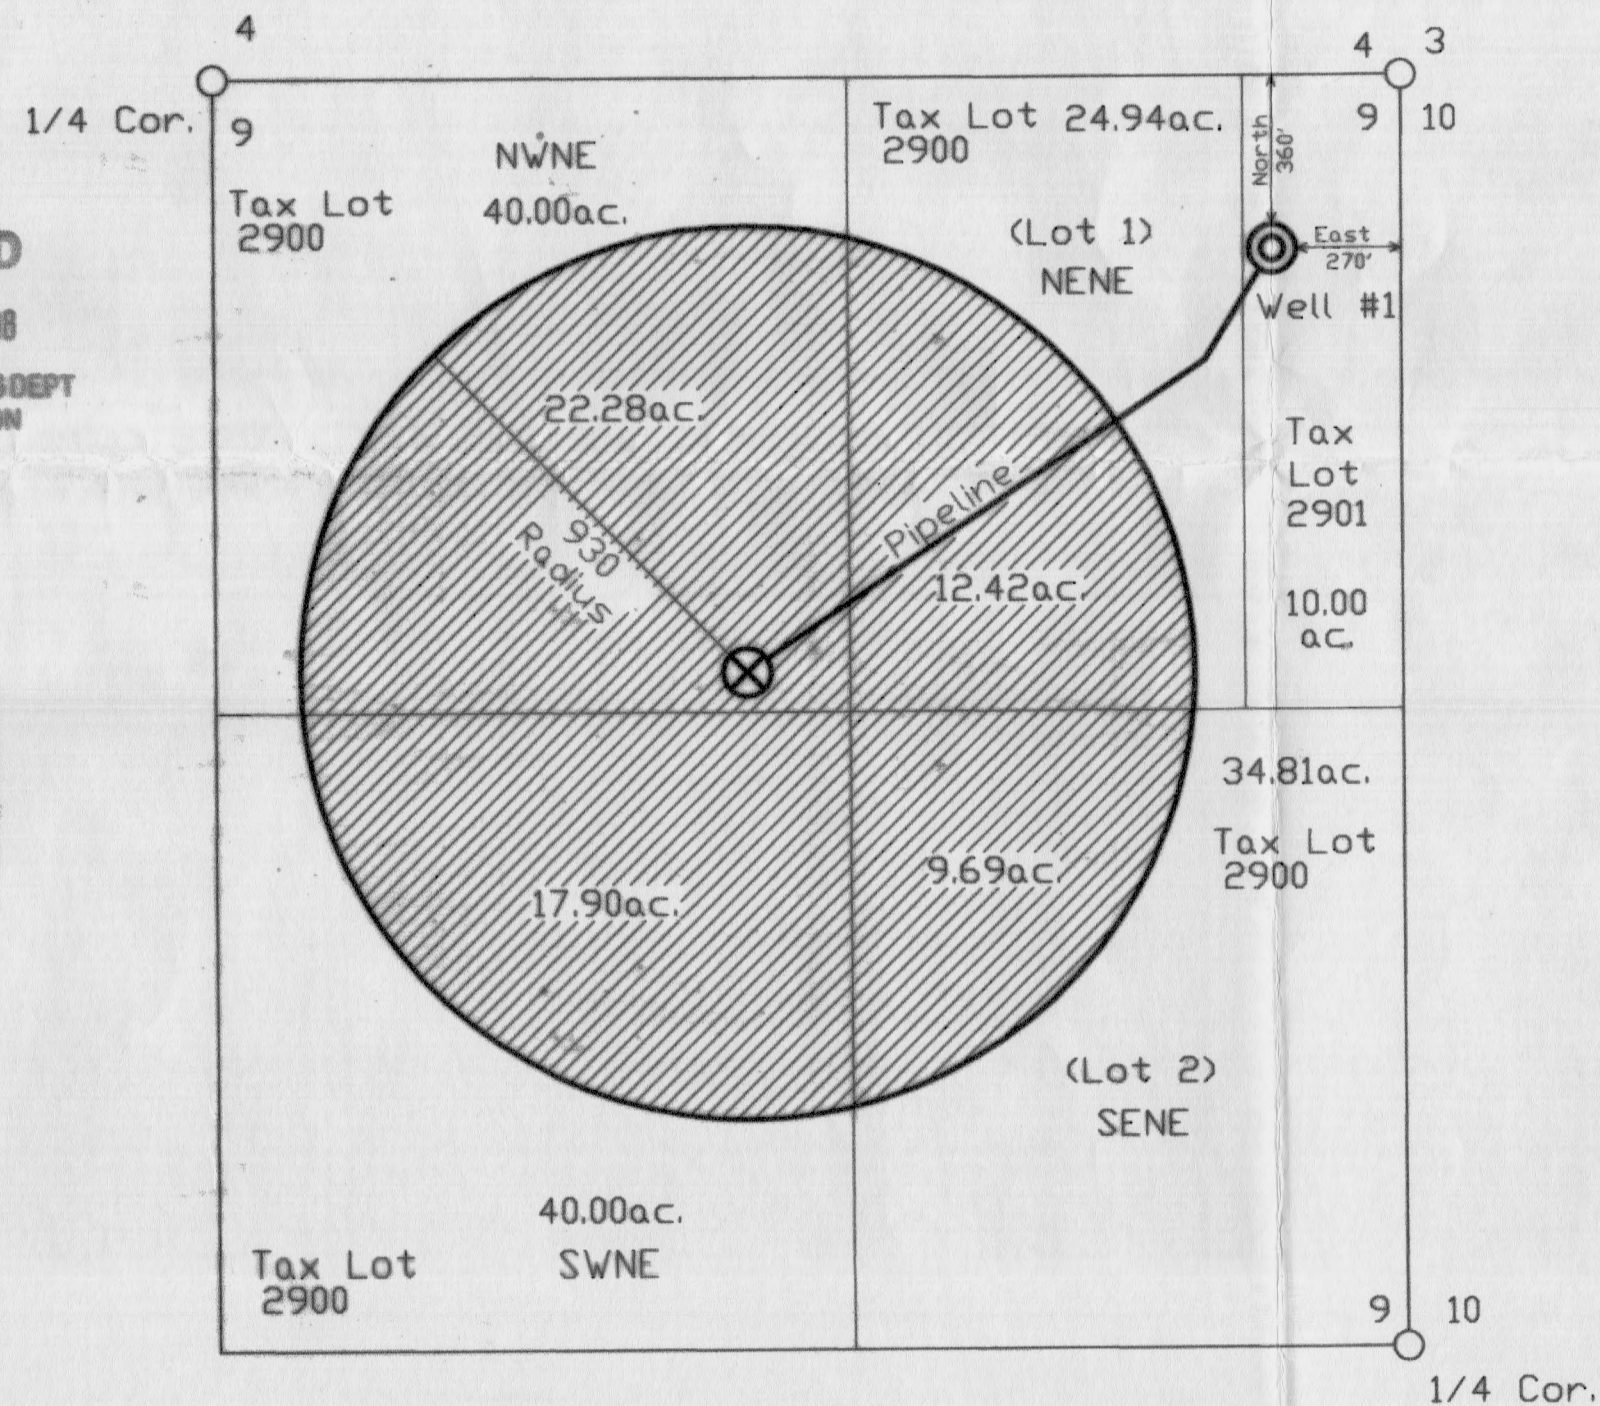

Carl Stout, WRE 412
Box 33
John Day, OR 97845

Legend

- ⊙ Well with impeller water meter.
- ⊗ Center of pivot
- GLO projected corners
- ▨ Irrigated lands

Total acres irrigated: 62.29ac

COBU MAP # 0376