


RECEIVED BY OWRD

MAY 08 2015

SALEM, OR

# Map

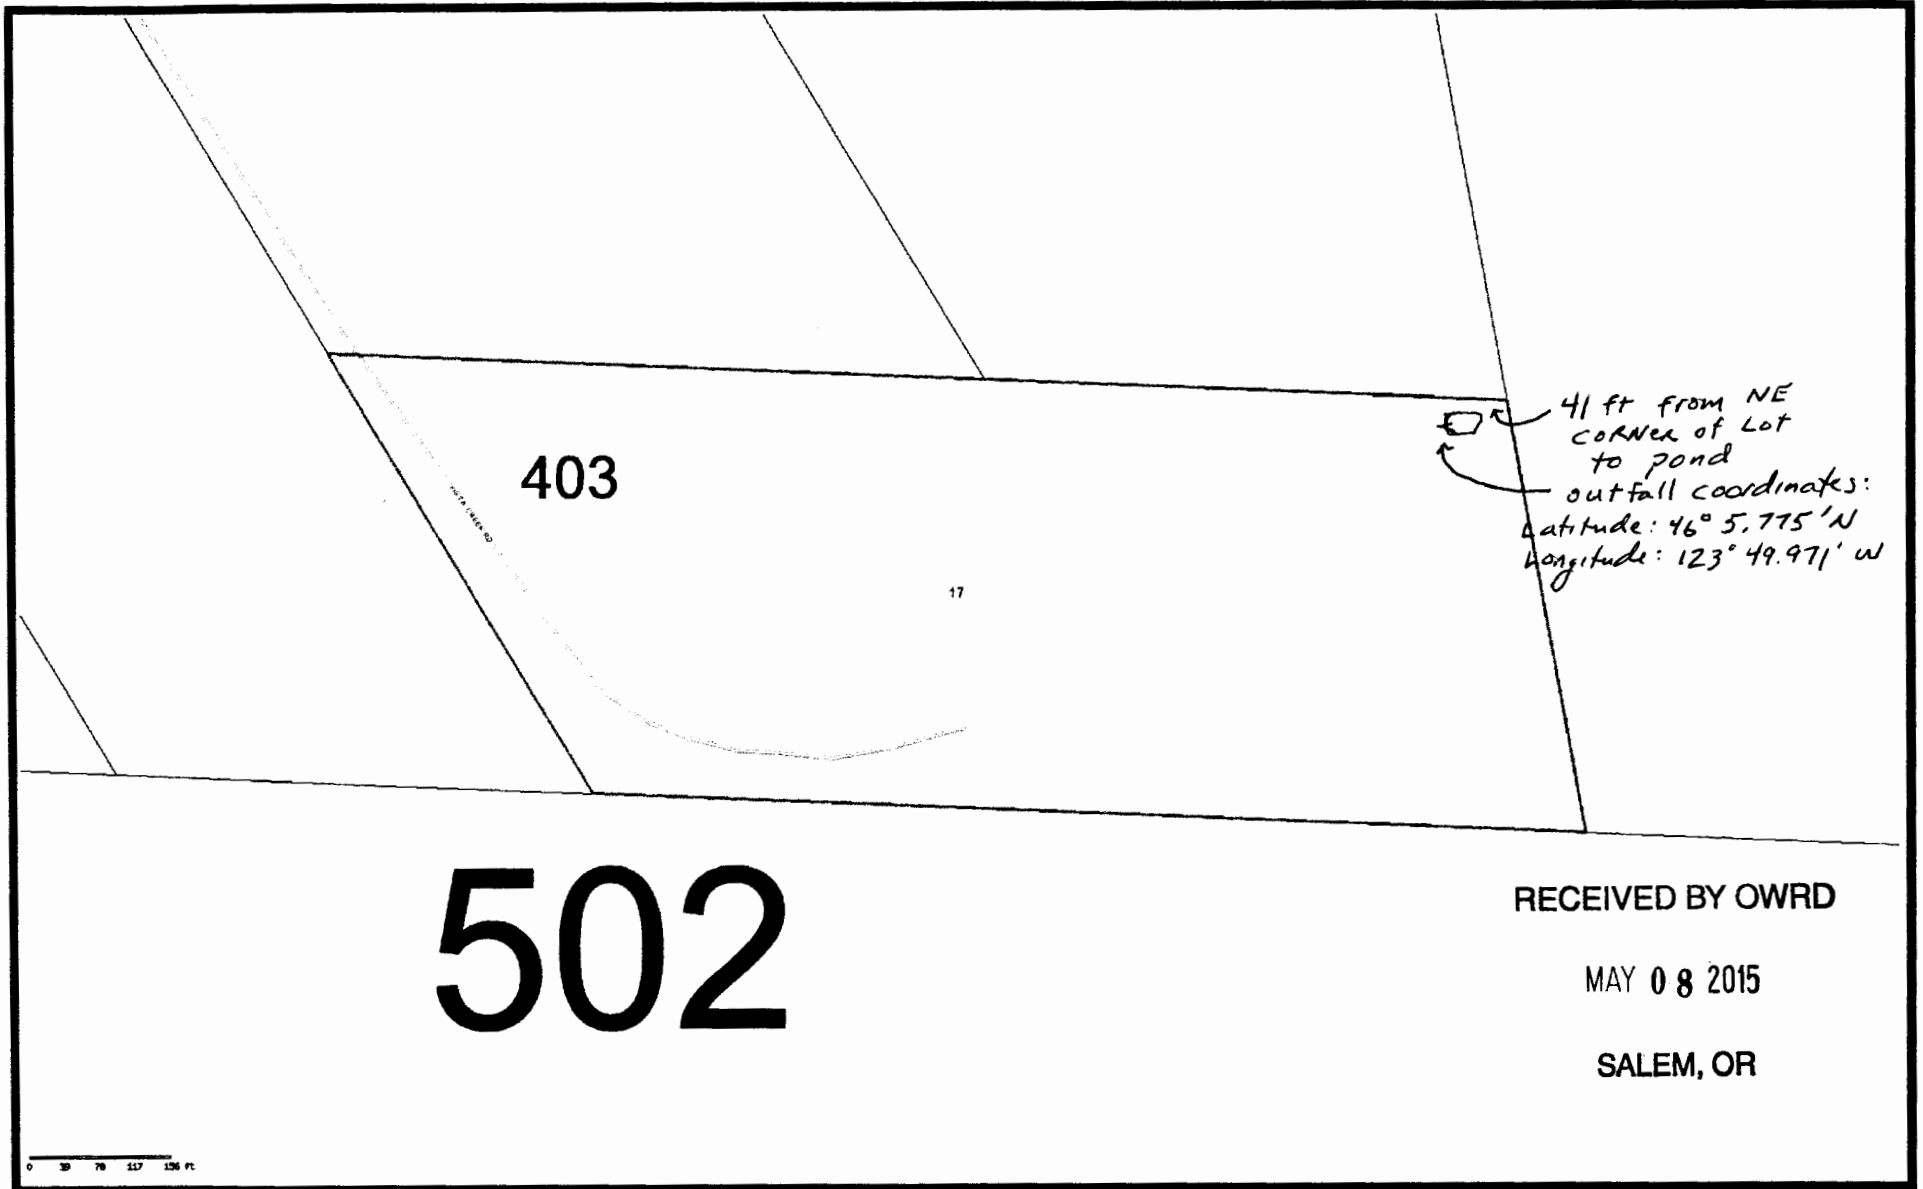

RECEIVED BY OWRD

MAY 08 2015

SALEM, OR



## Clatsop County Webmaps

Disclaimer: This map was produced using Clatsop County GIS data. The GIS data is maintained by the County to support its governmental activities. This map should not be used for survey or engineering purposes. The County is not responsible for map errors, omissions, misuse or misinterpretation. Photos may not align with taxlots.

