


CLAIM OF BENEFICIAL USE
 FOR: SCOTT G. WOODRUFF
 AND DONNA L. WOODRUFF
 BY: DUANE W. KIRBY
 T25S, R6W, W.M., SEC. 23
 APPLICATION NO. 72567
 PERMIT NO 52161
 DATE: JULY 2006

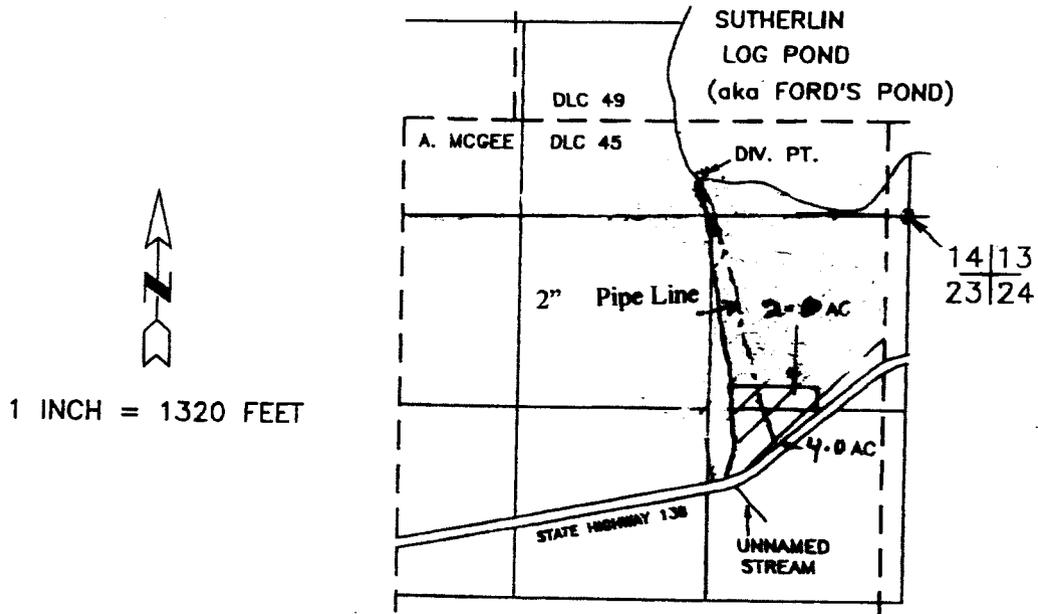

THE DIVERSION POINT IS LOCATED 280 FEET NORTH AND 1425 FEET ^{WEST} ~~EAST~~ FROM THE SE CORNER OF SECTION 14, BEING WITHIN THE SW 1/4 OF THE SE 1/4 OF SECTION 14, T 25 S, R 6 W, W M, AS PROJECTED WITHIN A. MCGEE DLC 45. ^{gsk/wrd 6-10-15}

THE PURPOSE OF THIS MAP IS TO IDENTIFY THE LOCATION OF THE WATER RIGHT. IT IS NOT INTENDED TO PROVIDE LEGAL DIMENSIONS OR THE LOCATION OF PROPERTY OWNERSHIP LINES.



RECEIVED
 AUG 04 2006
 WATER RESOURCES DEPT
 SALEM, OREGON