



FINAL PROOF SURVEY MAP
IN THE NAME OF LAURAL CREEK ACRES
PERMIT ISSUED TO ADEANE L. PATRICK
IN
TOWNSHIP 29 SOUTH, RANGE 14 WEST, SECTION 31, W.M.
COOS COUNTY, OREGON
APPLICATION R-72309 PERMIT R-11618
S-72310 51859

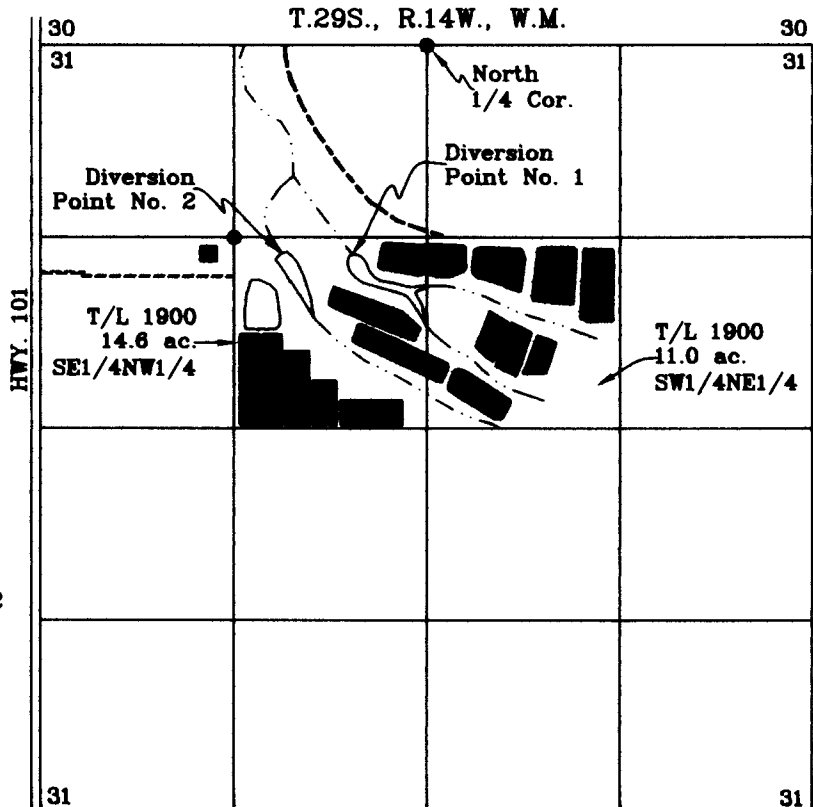


Scale: 1"=1320'
 Date: Sept. 22, 2009

LEGEND

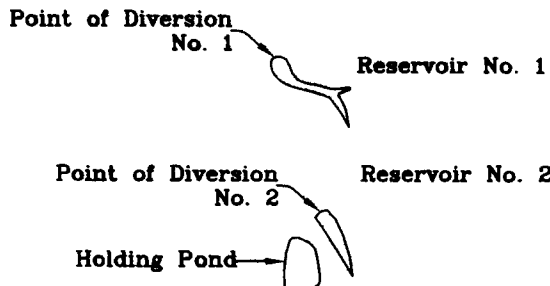

Point of Diversion No. 1 is located 1450 ft. south and 420 ft. west and Point of Diversion No. 2 is located 1410 ft. south and 980 ft. west; both from the north quarter corner of Section 31 and are located within the SE1/4 NW1/4 of Section 31, Township 29 South, Range 14 West, Willamette Meridian; Coos County, Oregon.

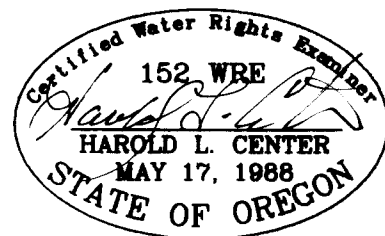

This map was prepared for the purpose of identifying the location of a water right only and is not intended to provide legal dimensions or location of property ownership.

HAROLD L. CENTER
 2604 David Lane
 Medford, OR. 97504
 Phone 541-535-6108
 Oregon Certificate No. 152
 Cert. Renewal Date: 12/31/2009 *11/26*

RECEIVED

DEC 01 2009

WATER RESOURCES DEPT
 SALEM, OREGON