


**FINAL PROOF SURVEY MAP  
IN THE NAME OF LAUREL CREEK ACRES, LLC**

**APPLICATION R-72438  
S-72439**

**PERMIT R-11755  
S-52121**

**SECTION 31, TOWNSHIP 29 SOUTH, RANGE 14 WEST, W.M.**

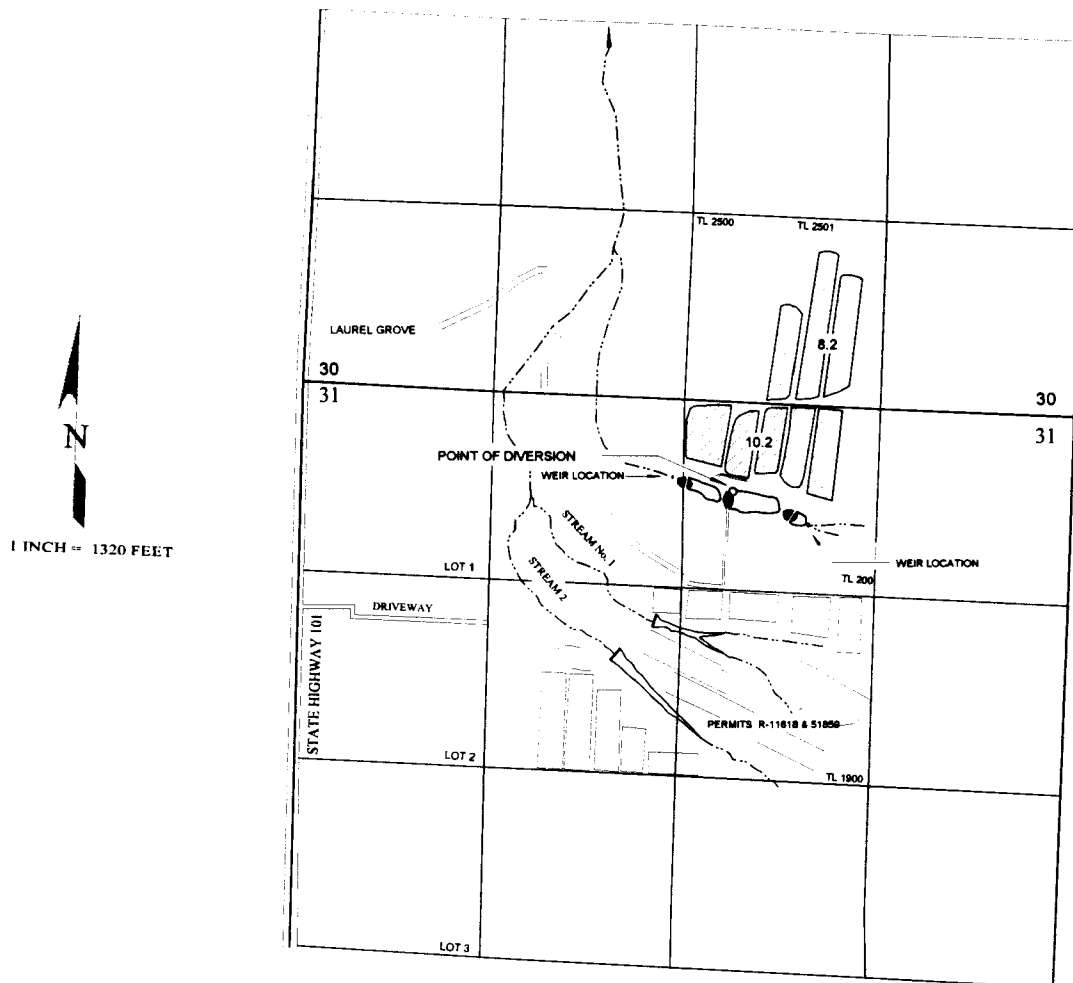

THE POINT OF DIVERSION IS LOCATED 325 FEET EAST AND 640 FEET SOUTH  
FROM THE NORTH QUARTER CORNER OF SECTION 31; BEING WITHIN THE NW $\frac{1}{4}$  NE $\frac{1}{4}$   
OF SECTION 31, TOWNSHIP 29 SOUTH, RANGE 14 WEST, W.M.; COOS COUNTY.

THE DAMS ARE LOCATED AS FOLLOWS:

- No. 1: 570 FEET SOUTH AND 5 FEET EAST;  
No. 2: 675 FEET SOUTH AND 295 FEET EAST; AND  
No. 3: 800 FEET SOUTH AND 720 FEET EAST; ALL  
FROM THE NORTH QUARTER CORNER OF SECTION 31; BEING WITHIN THE  
NW $\frac{1}{4}$  NE $\frac{1}{4}$  OF SECTION 31, TOWNSHIP 29 SOUTH, RANGE 14 WEST, W.M.;  
COOS COUNTY.

**RECEIVED**

WATER RESOURCES DEPT  
SALEM, OREGON

