


T.6S., R.1E., W.M.

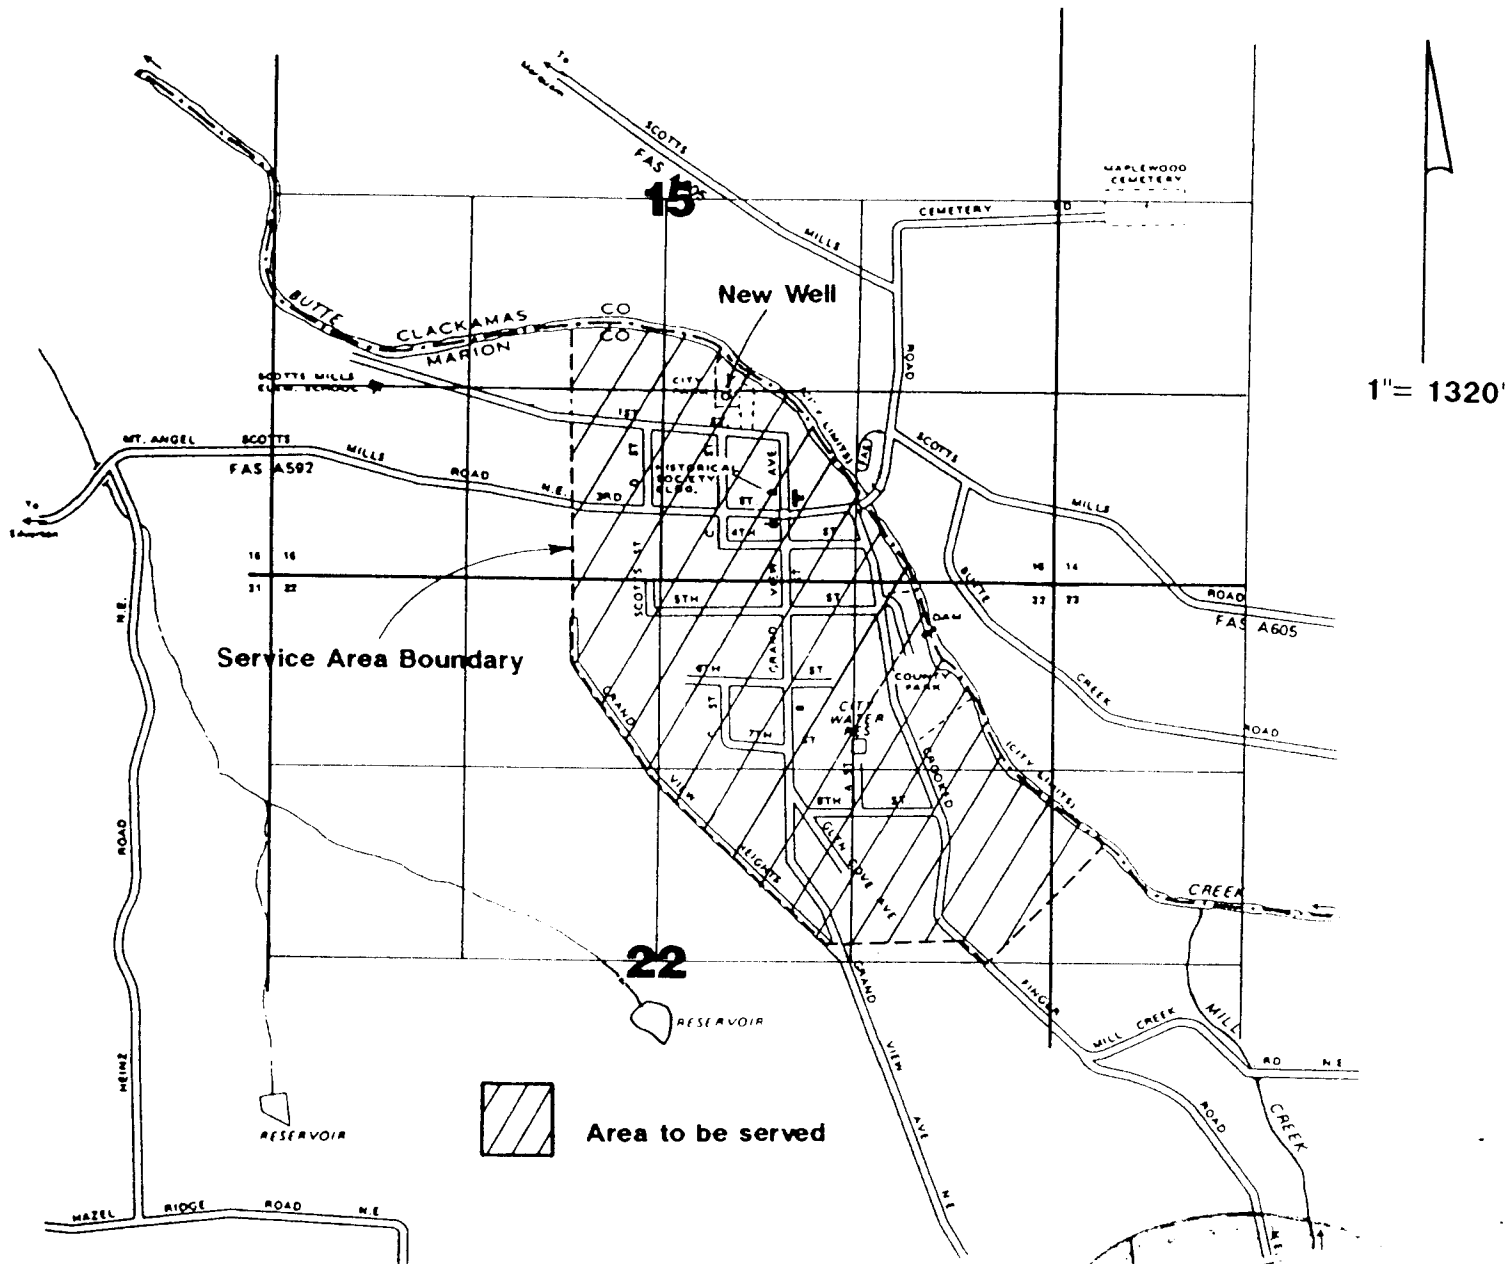

Well located 2200'W & 1290'N from SE Cor. Section 15.

Handwritten signature

Final Proof Survey

Application #G-11936 Permit #G-11009

In Name Of

City of Scotts Mills

Surveyed on September 16, 1994 by JM Schuette

THIS MAP WAS PREPARED FOR THE PURPOSE OF IDENTIFYING THE LOCATION OF A WATER RIGHT ONLY AND IS NOT INTENDED TO PROVIDE LEGAL DIMENSIONS OR LOCATION OF PROPERTY OWNERSHIP LINES