




TRANSFER APPLICATION MAP
Certificate 20412
Section 20, T3S, R1W, W.M., Clackamas County
James A. Bisenius, Janet L. Bisenius and Bizzy B Seven LLC.

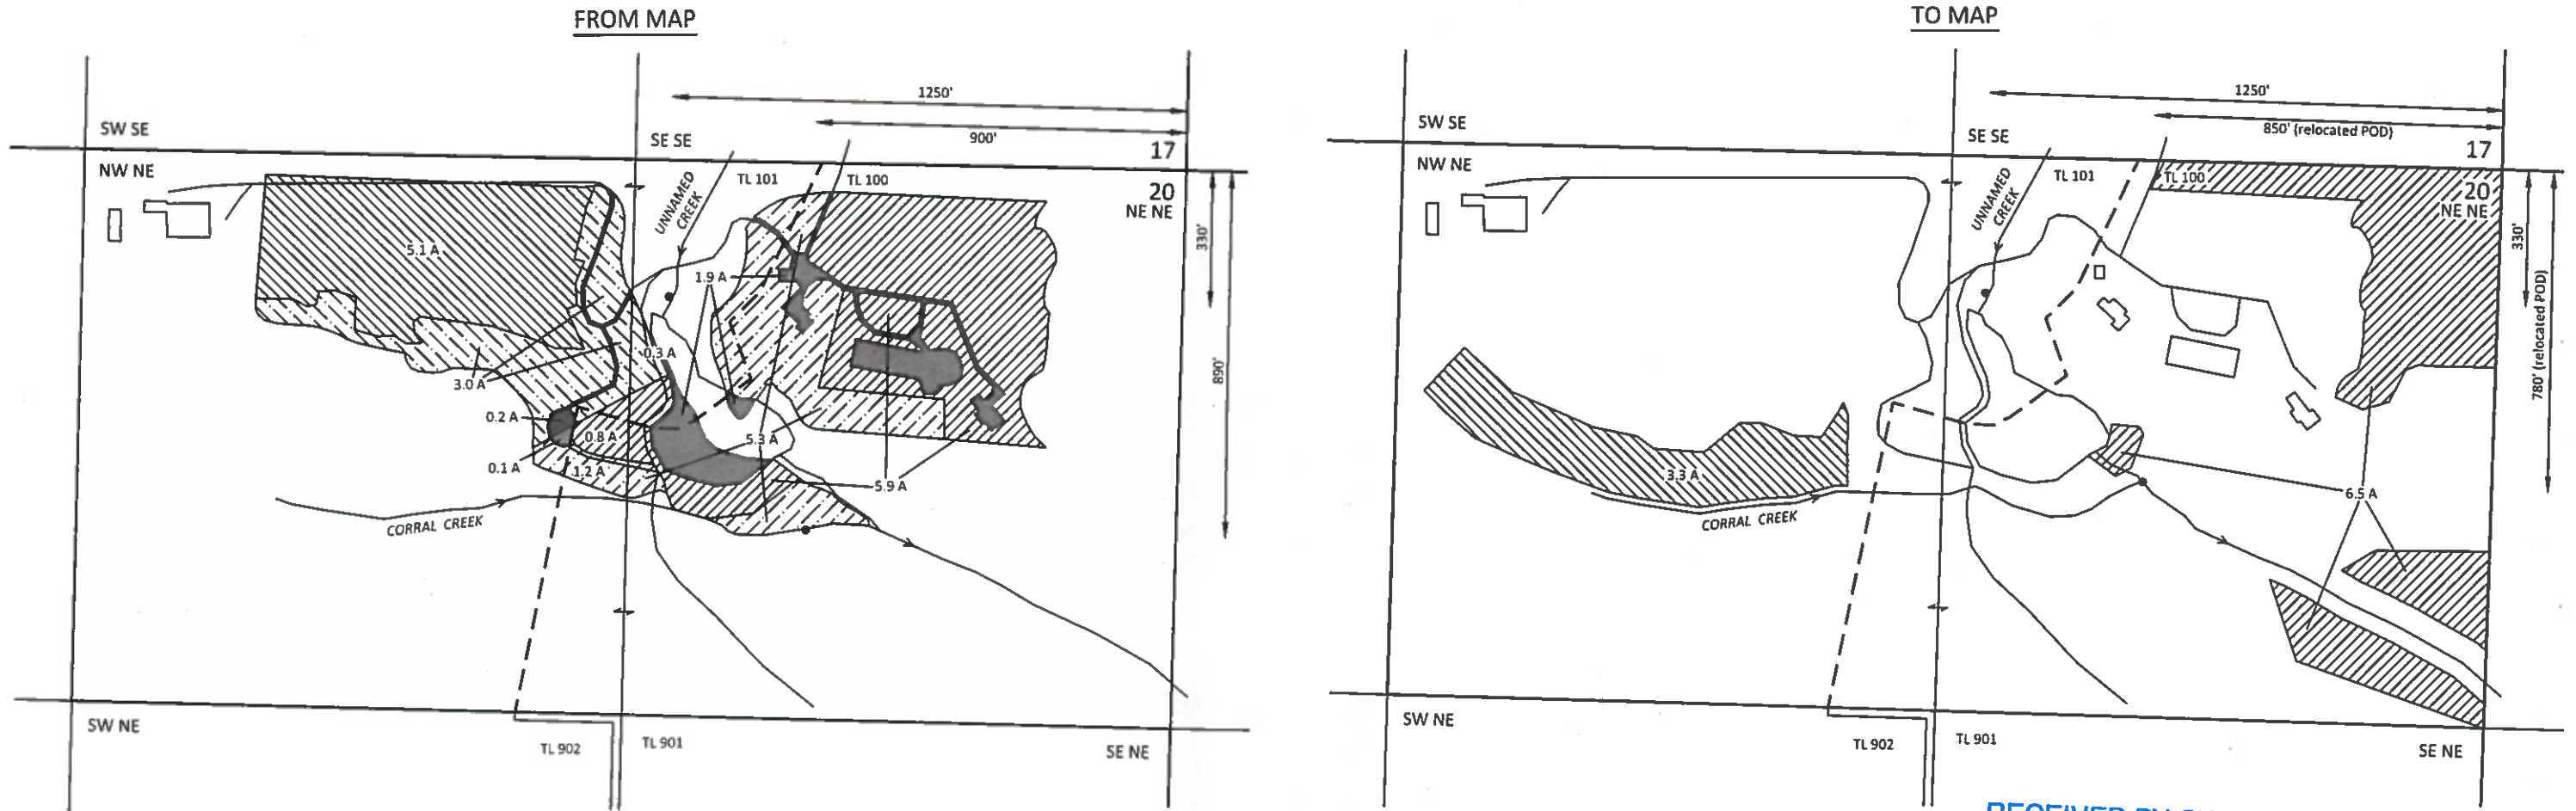

RECEIVED BY OWRD

MAR 02 2015

SALEM, OR

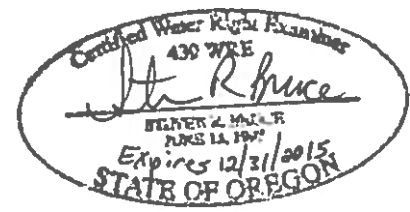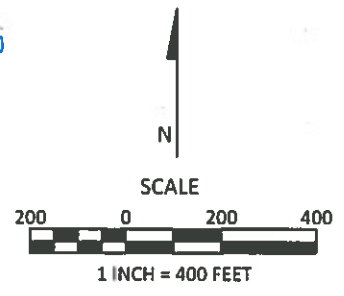

REMAINING RIGHTS

- CERTIFICATE 20412 (5.1 AC)
IRRIGATION - UNNAMED CREEK SOURCE
PRIORITY: 5/28/1947
- CERTIFICATE 20412 (6.7 AC)
IRRIGATION - CORRAL CREEK SOURCE
PRIORITY: 5/17/1947

EXPLANATION

FROM LANDS

- CERTIFICATE 20412 (3.3 AC)
IRRIGATION - UNNAMED CREEK SOURCE
PRIORITY: 5/28/1947
- CERTIFICATE 20412 (6.5 AC)
IRRIGATION - CORRAL CREEK SOURCE
PRIORITY: 5/17/1947

CANCELED RIGHTS

- CERTIFICATE 20412 (0.2 AC)
IRRIGATION - UNNAMED CREEK SOURCE
PRIORITY: 5/28/1947
- CERTIFICATE 20412 (2.0 AC)
IRRIGATION - CORRAL CREEK SOURCE
PRIORITY: 5/17/1947

TO LANDS

- CERTIFICATE 20412 (3.3 AC)
IRRIGATION - UNNAMED CREEK SOURCE
PRIORITY: 5/28/1947
- CERTIFICATE 20412 (6.5 AC)
IRRIGATION - CORRAL CREEK SOURCE
PRIORITY: 5/17/1947

- TAXLOT BOUNDARY
- POINT OF DIVERSION (POD)

The Point of Diversion relocation on the To Map is not a transfer, but a move as allowed under Oregon Revised Statute (ORS) 540.510(5).

January 5, 2015

This map is not intended to provide legal dimensions or locations of property ownership lines


FIGURE 1

SKOOKUM
WATER ASSOCIATES INC

P.O. BOX 80174
PORTLAND, OR 97280
(503) 319-8926

T 11996


TRANSFER APPLICATION MAP
Certificate 20412
 Section 20, T3S, R1W, W.M., Clackamas County
 James A. Bisenius, Janet L. Bisenius and Bizzy B Seven LLC.

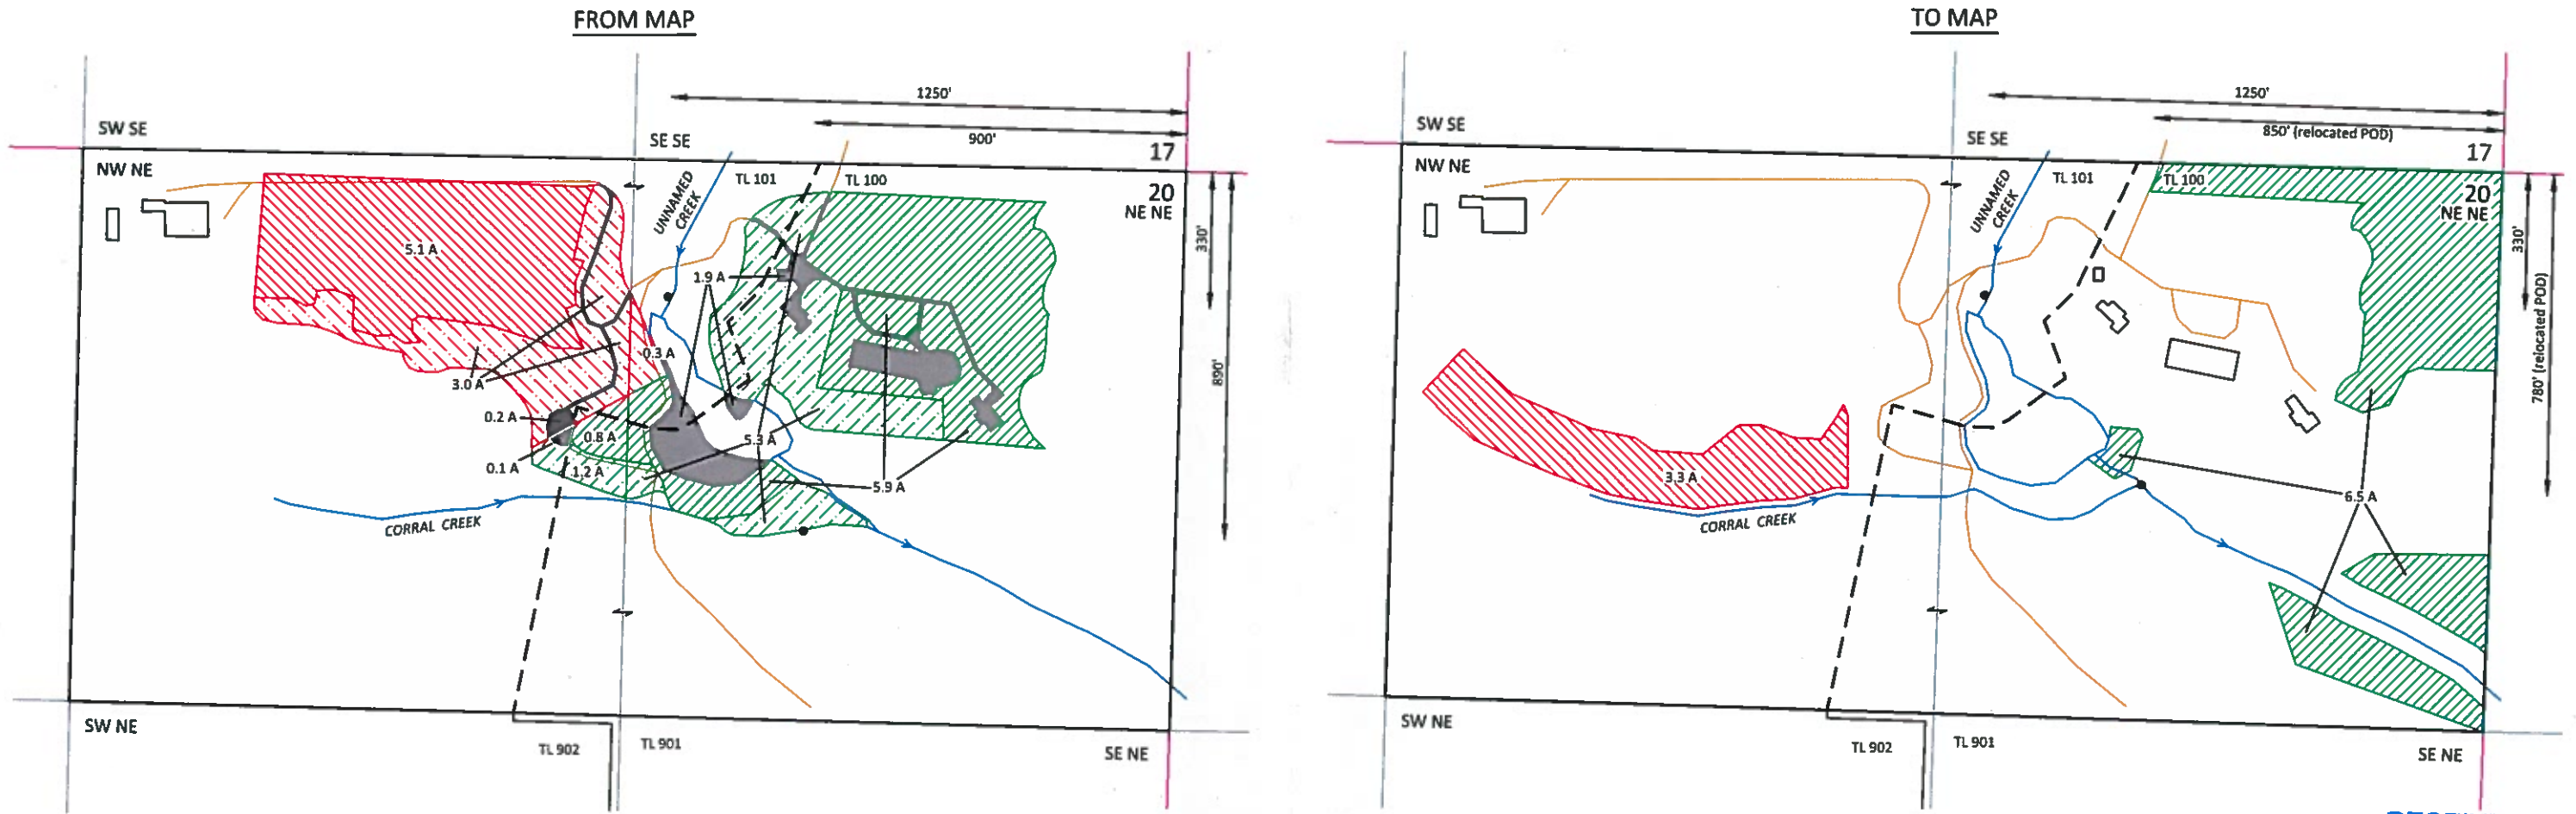

RECEIVED BY OWRD

MAR 02 2015

SALEM, OR

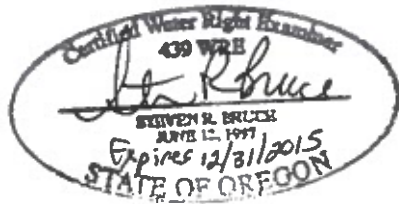

REMAINING RIGHTS

- CERTIFICATE 20412 (5.1 AC)
IRRIGATION - UNNAMED CREEK SOURCE
PRIORITY: 5/28/1947
- CERTIFICATE 20412 (6.7 AC)
IRRIGATION - CORRAL CREEK SOURCE
PRIORITY: 5/17/1947

The Point of Diversion relocation on the To Map is not a transfer, but a move as allowed under Oregon Revised Statute (ORS) 540.510(5).

EXPLANATION

FROM LANDS

- CERTIFICATE 20412 (3.3 AC)
IRRIGATION - UNNAMED CREEK SOURCE
PRIORITY: 5/28/1947
- CERTIFICATE 20412 (6.5 AC)
IRRIGATION - CORRAL CREEK SOURCE
PRIORITY: 5/17/1947


TO LANDS

- CERTIFICATE 20412 (3.3 AC)
IRRIGATION - UNNAMED CREEK SOURCE
PRIORITY: 5/28/1947
- CERTIFICATE 20412 (6.5 AC)
IRRIGATION - CORRAL CREEK SOURCE
PRIORITY: 5/17/1947

CANCELED RIGHTS

- CERTIFICATE 20412 (0.2 AC)
IRRIGATION - UNNAMED CREEK SOURCE
PRIORITY: 5/28/1947
- CERTIFICATE 20412 (2.0 AC)
IRRIGATION - CORRAL CREEK SOURCE
PRIORITY: 5/17/1947

- TAXLOT BOUNDARY
- POINT OF DIVERSION (POD)

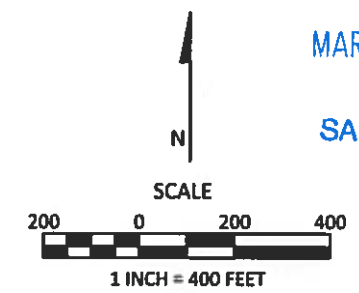

January 5, 2015

This map is not intended to provide legal dimensions or locations of property ownership lines

FIGURE 1

SKOOKUM
WATER ASSOCIATES INC

P.O. BOX 80174
PORTLAND, OR 97280
(503) 319-8926

T 11006