


# Township 5 North, Range 29 East, W.M.

## SW 1/4 & SE 1/4 of NW 1/4 of Section 28

2021  
2928

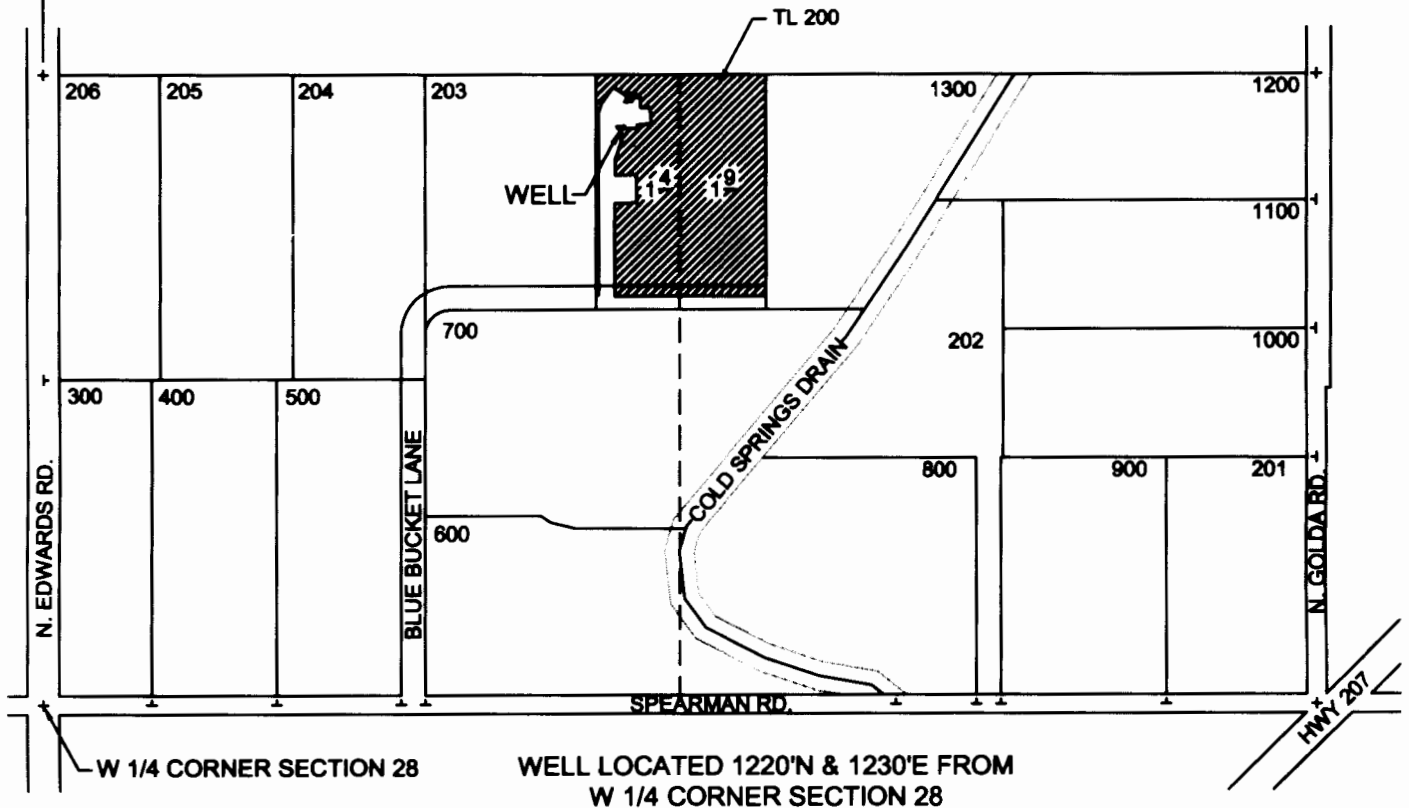

SCALE 1" = 400'

**FINAL PROOF SURVEY**  
under  
Appl. No. G-15129, Per. No. G-14073  
in name of  
**TERRY AND ANITA NELSON**  
July 18, 2006



EXPIRES: 6/30/08

THIS MAP WAS PREPARED FOR THE PURPOSE OF IDENTIFYING THE LOCATION OF A WATER RIGHT ONLY AND IS NOT INTENDED TO PROVIDE LEGAL DIMENSIONS OR LOCATION OF PROPERTY OWNERSHIP LINES.