


SECTION 16, T.5S R.1E. W.M.
CLACKAMAS COUNTY

RECEIVED

JAN 12 2007

WATER RESOURCES DEPT
SALEM, OREGON

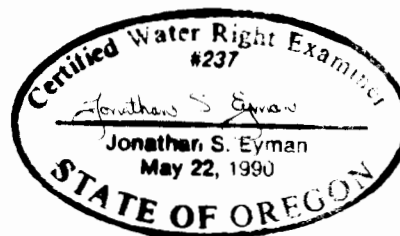

S. NEEDY ROAD

○ S. SCHNEIDER ROAD

1/4 CORNER
SECTION 16/17

4.0
acre

1.0
acre

WELL
with
WATER
METER

Field Access Road

TAX LOT
2100

TAX LOT
2101

21.3
acre

13.7
acre

TAX LOT
2102

CLAIM OF BENEFICIAL USE
FOR
WALLACE KROFF

APPLICATION #G-15856 PERMIT #G-15590

WELL IS LOCATED 2611 FEET EAST AND 99 FEET SOUTH OF
THE 1/4 CORNER BETWEEN SECTION 16 AND SECTION 17



CERTIFICATE GR-3747



APPLICATION G-15856



TAX LOT 2100



TAX LOT 2102



TAX LOT 2101



TAX LOT 3100 IS
FIELD ACCESS ROAD
IN NE CORNER

THE PREPARATION OF THIS MAP IS FOR THE
PURPOSE OF IDENTIFYING THE LOCATION
OF THE WATER RIGHT ONLY AND HAS NO
INTENT TO PROVIDE DIMENSIONS OR LOCATION
OF PROPERTY OWNERSHIP LINES.

April 25, 2006

2006405_JSE_03

Scale: 1" = 400'