



**Claim of Beneficial Use
in Jackson County
Township 36 S, Range 4 W, Section 20, W.M.**

**Kensett J. Moyle
Application S-85328 Permit 53979
Application R-85638 Permit R-13761**

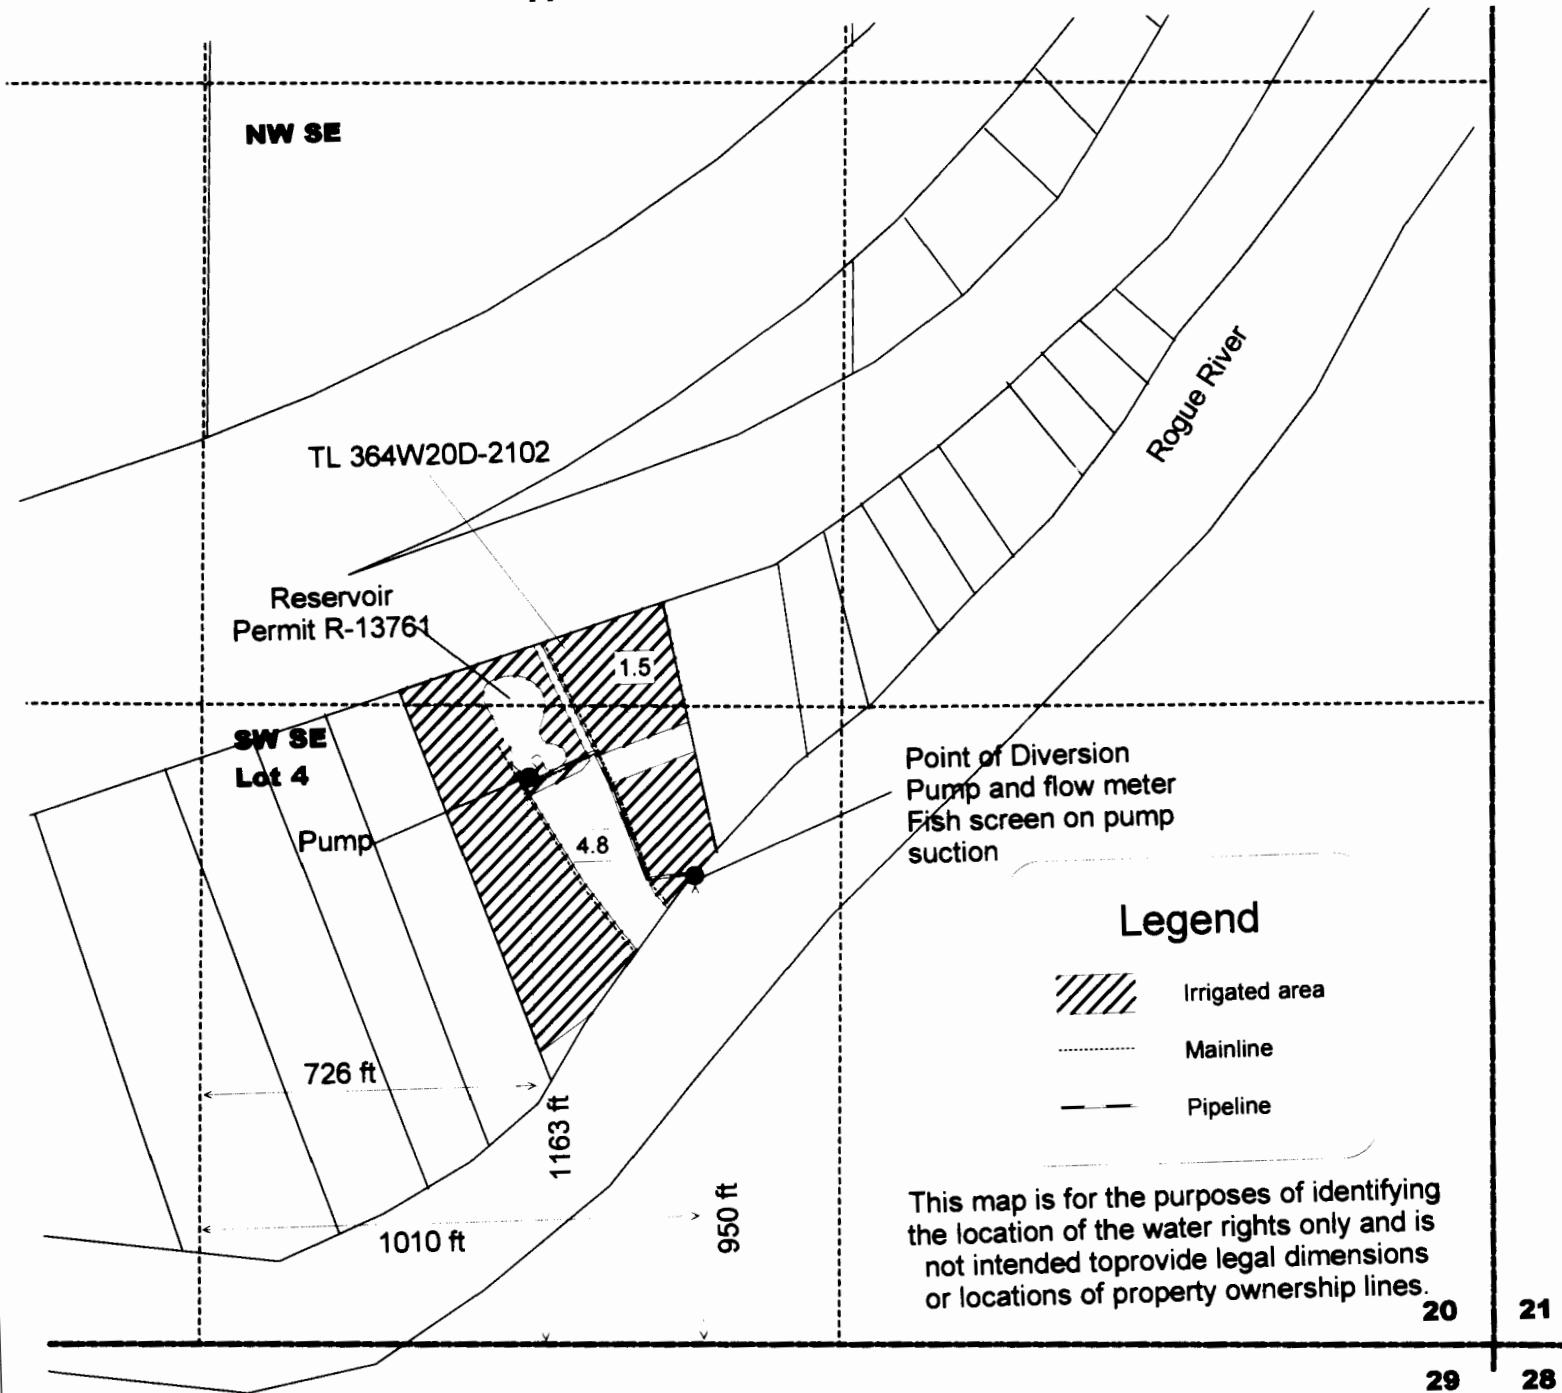


This map is for the purposes of identifying the location of the water rights only and is not intended to provide legal dimensions or locations of property ownership lines.

20 21
29 28

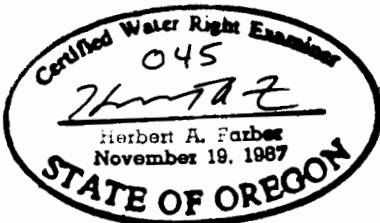

RENEWAL DATE 12-31-07

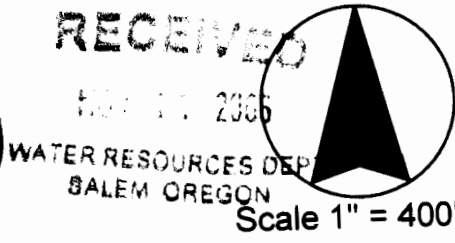

FARBER SURVEYING
 PO Box 5286
 Central Point, Oregon 97502
 Phone 541-664-5599
 Fax 541-664-5603
 Email hfarber@charter.net
 Farber & Sons, Inc.
 431 Oak Street
 Central Point, Oregon
 Tax ID: 93-1057173