



Map to Accompany Claim of Beneficial Use
For Permits R-11923 & 52609, Appl.# R-74055 & 74054
In the Name of Drift One, LLC

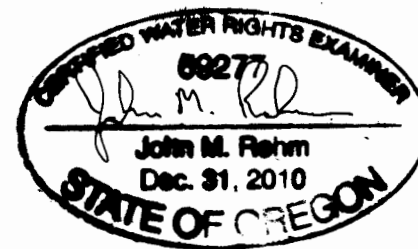

T.8 S., R.11 W., WM
S1/2 NE1/4, Section 1

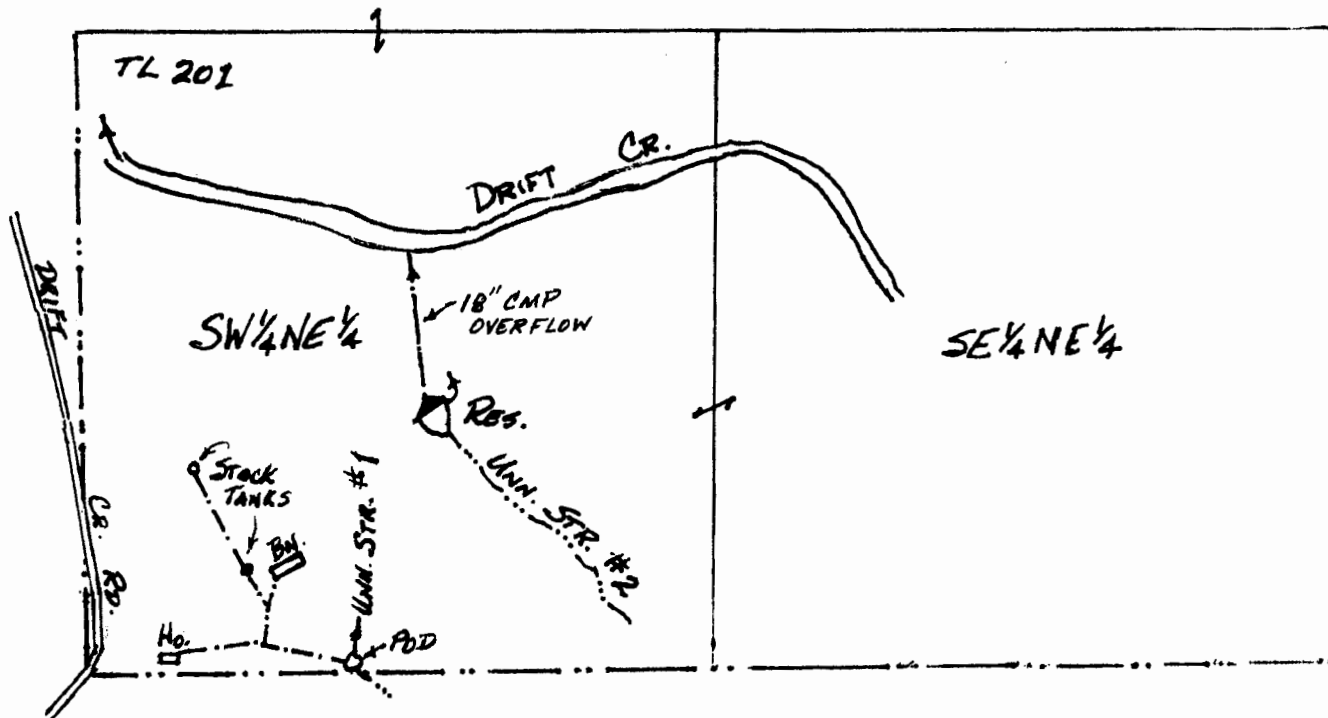

POD's Located: Unnamed Stream #1- 20' N. & 550' E.; Reservoir (Unnamed Stream #2)- 530' N. & 730' E.; both from the Center 1/4 Corner, Section 1.

This map is for the purpose of identifying the location of water rights only, and is not Intended to provide legal dimensions or locations of property lines.

02/2015 JMR