


T. 33 S., R. 7 1/2 E. W.M.

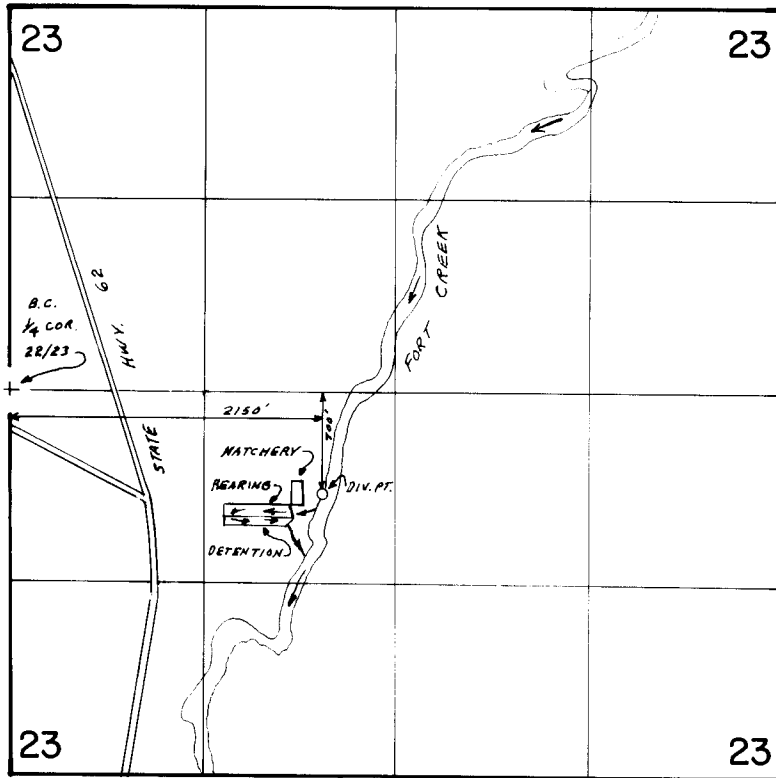

SCALE: 1"=1320'

**FINAL PROOF SURVEY**  
UNDER

Application No. 63961 Permit No. 47187.....  
IN NAME OF

.....ANADRAOMOUS INC.....

Surveyed AUG. 20 19 87, by J.M. SCHMORDE.....