


FINAL PROOF SURVEY MAP IN THE NAME OF ADRIENNE GOOD

APPLICATION R - 73473
S - 73472


PERMIT R - 12695
53588

SECTION 27, TOWNSHIP 31 SOUTH, RANGE 15 WEST, W.M.

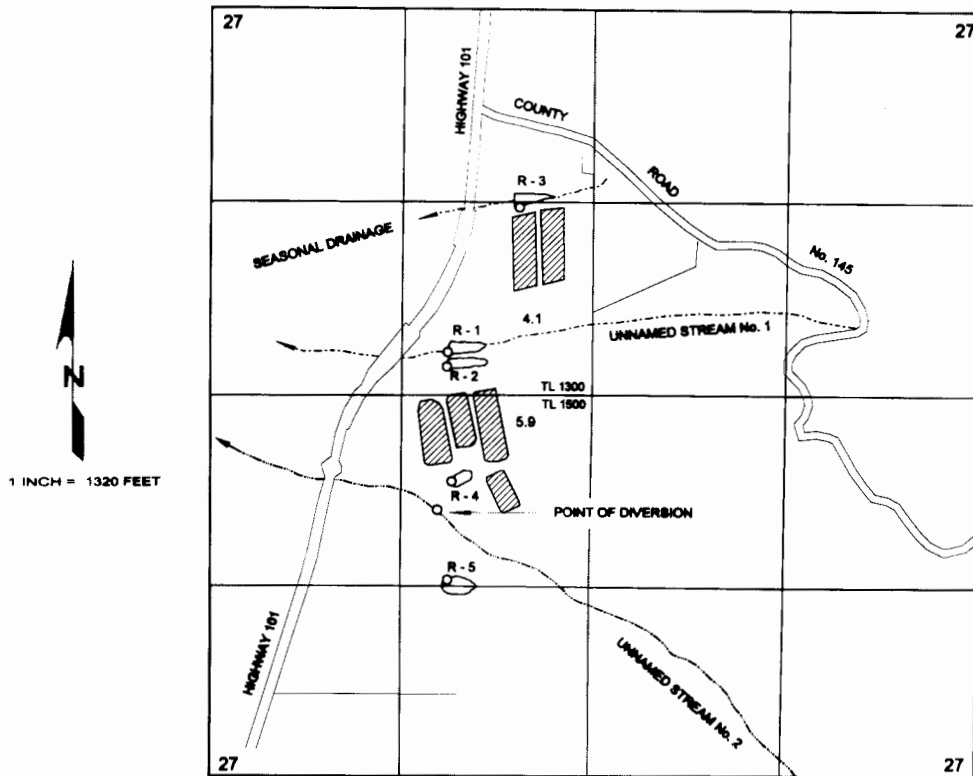

THE POINTS OF DIVERSION ARE LOCATED AS FOLLOWS:

RESERVOIR No. 1 (UNNAMED STREAM No. 1) IS LOCATED 300 FEET NORTH AND 1630 FEET EAST; WITHIN THE SE $\frac{1}{4}$ NW $\frac{1}{4}$; AND UNNAMED STREAM No. 2 IS LOCATED 810 FEET SOUTH AND 1570 FEET EAST; WITHIN THE NE $\frac{1}{4}$ SW $\frac{1}{4}$; AND RESERVOIR No. 2 IS LOCATED 200 FEET NORTH AND 1630 FEET EAST; WITHIN THE SE $\frac{1}{4}$ NW $\frac{1}{4}$; AND RESERVOIR No. 3 IS LOCATED 1320 FEET NORTH AND 2120 FEET EAST; WITHIN THE SE $\frac{1}{4}$ NW $\frac{1}{4}$; AND RESERVOIR No. 4 IS LOCATED 810 FEET SOUTH AND 1690 FEET EAST; WITHIN THE NE $\frac{1}{4}$ SW $\frac{1}{4}$; AND RESERVOIR No. 5 IS LOCATED 1300 FEET SOUTH AND 1630 FEET EAST; WITHIN THE NE $\frac{1}{4}$ SW $\frac{1}{4}$; ALL FROM THE WEST QUARTER CORNER OF SECTION 27 AND WITHIN SECTION 27, TOWNSHIP 31 SOUTH, RANGE 15 WEST, W.M.; CURRY COUNTY.

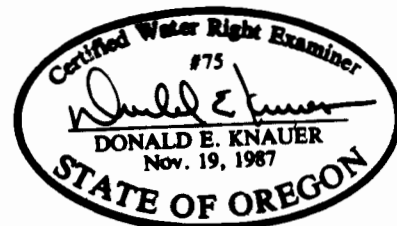

THE PURPOSE OF THIS MAP IS TO IDENTIFY THE LOCATION OF THE WATER RIGHT.
IT IS NOT INTENDED TO PROVIDE INFORMATION RELATIVE TO THE LOCATION OF
PROPERTY OWNERSHIP BOUNDARY LINES.