



Claim of Beneficial Use - Well Location Map
Application G-12050; Permit G-11324
City of Klamath Falls
Klamath County, Oregon
Government Lot 8, Section 32, Township 38 South,
Range 9 East (W.M.)

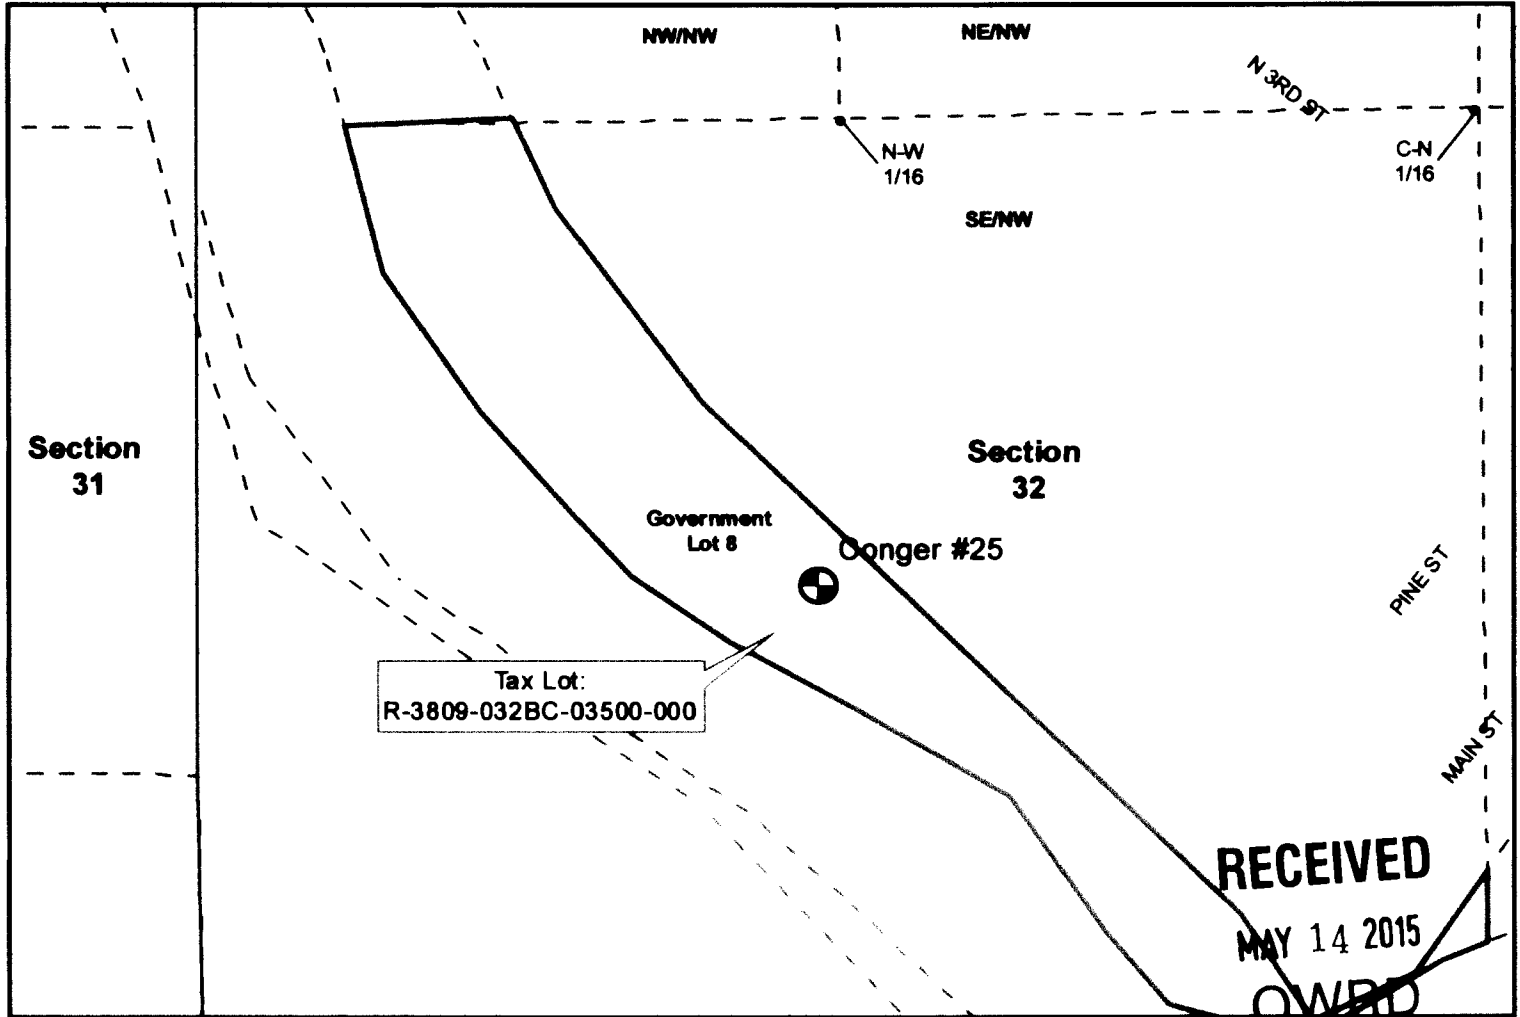

Legend

- Conger Well 25
- Section Line
- Government Lots
- Tax Lot
- 1/4 Section & Meander Line

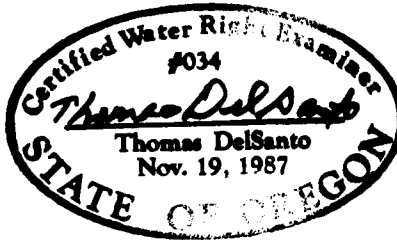

Map Information
 Projection: OCRS Bend-Klamath Falls Zone
 Datum: North American Datum of 1983
 Date: April 15, 2015
 Prepared by: City of Klamath Falls

Data Sources
 City of Klamath Falls


NOTES:

- 1) The water meter is a Sensus Propeller Meter w/ Electric Output, Totalizer x 1000 Gal., and located in the well house approximately 9ft northwesterly x 6ft northeasterly from the main door.
- 2) Conveyance System: Refer to the system overview map in Attachment 1.

Disclaimer
 This map was prepared for the purpose of identifying the location of a water right only and is not intended to provide legal dimensions or location of property ownership lines.


POA Location Description

Conger #25
 Located 378 Feet North and 1271 Feet East from W 1/4 corner of Section 32, Township 38 South, Range 9 East (W.M.)

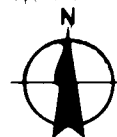


0 400

 1 inch equals 400 feet

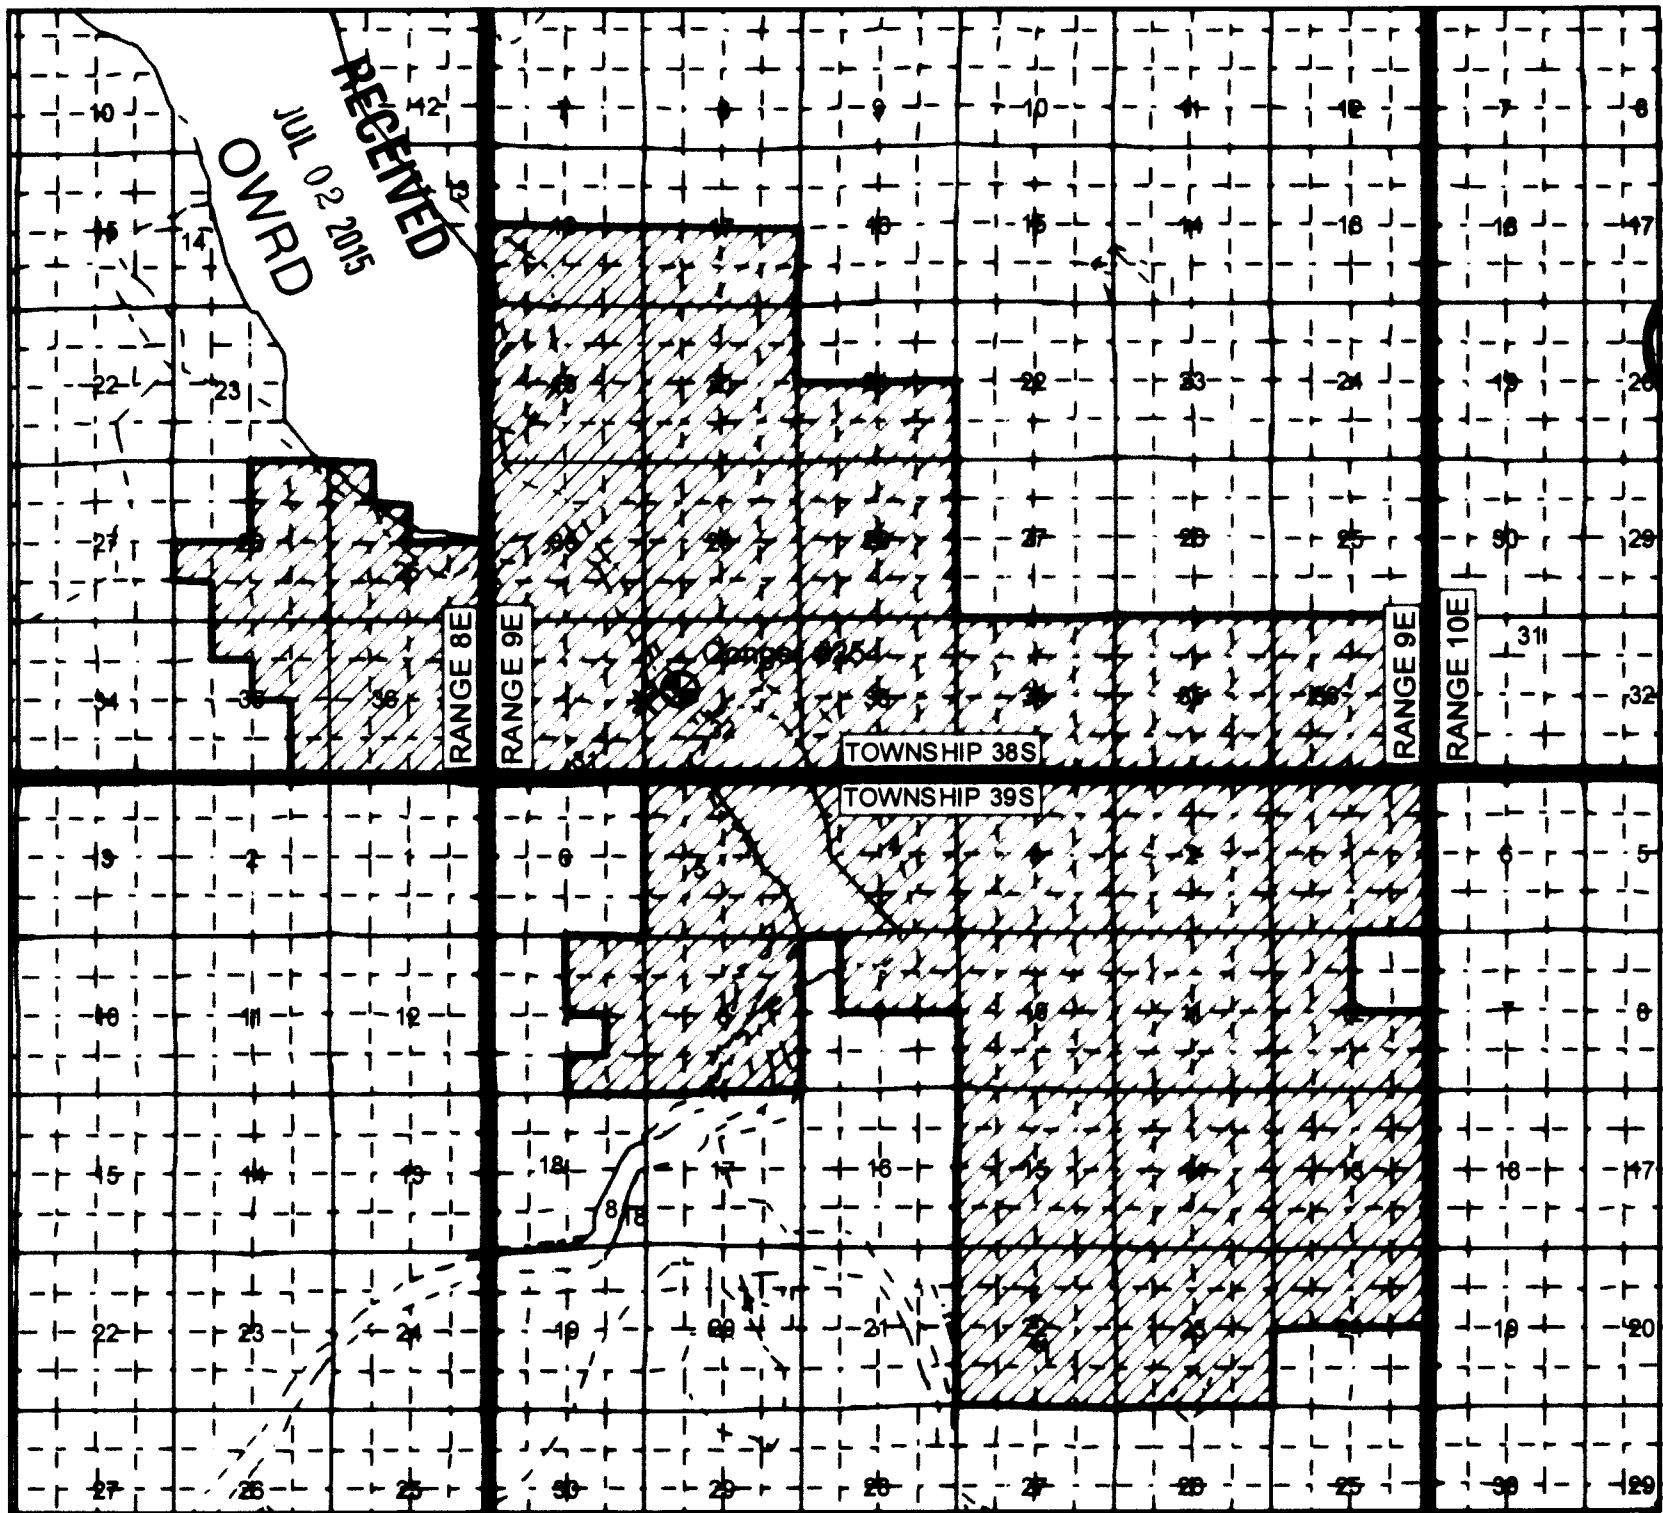

Claim of Beneficial Use
 Place of Use Map
 Application G-12050
 Permit G-11324
 City of Klamath Falls
 Klamath County, Oregon


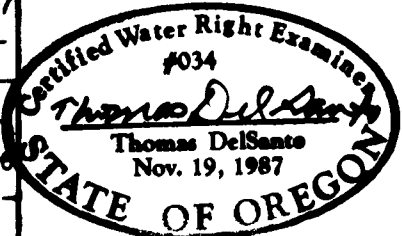


- Legend**
- Point of Appropriation (POA)
 - Place of Use: Permit G-11324
 - W1/4, Sec. 32, T38S, R9E
- Conger Well 25 located 378' North/
 1271' East from W1/4 Sec. 32


Map Information
 Projection: OCRS Bend-Klamath
 Falls Zone
 Datum: North American Datum of
 1983
 Date: Rev. 6/15/15
 Prepared by: City of Klamath Falls

Data Sources
 City of Klamath Falls

Disclaimer
 This map was prepared for the
 purpose of identifying the location
 of a water right only and is not
 intended to provide legal
 dimensions or location of property
 ownership lines.

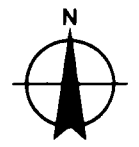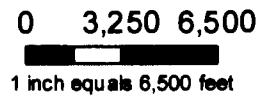

City of Klamath Falls System Overview Map

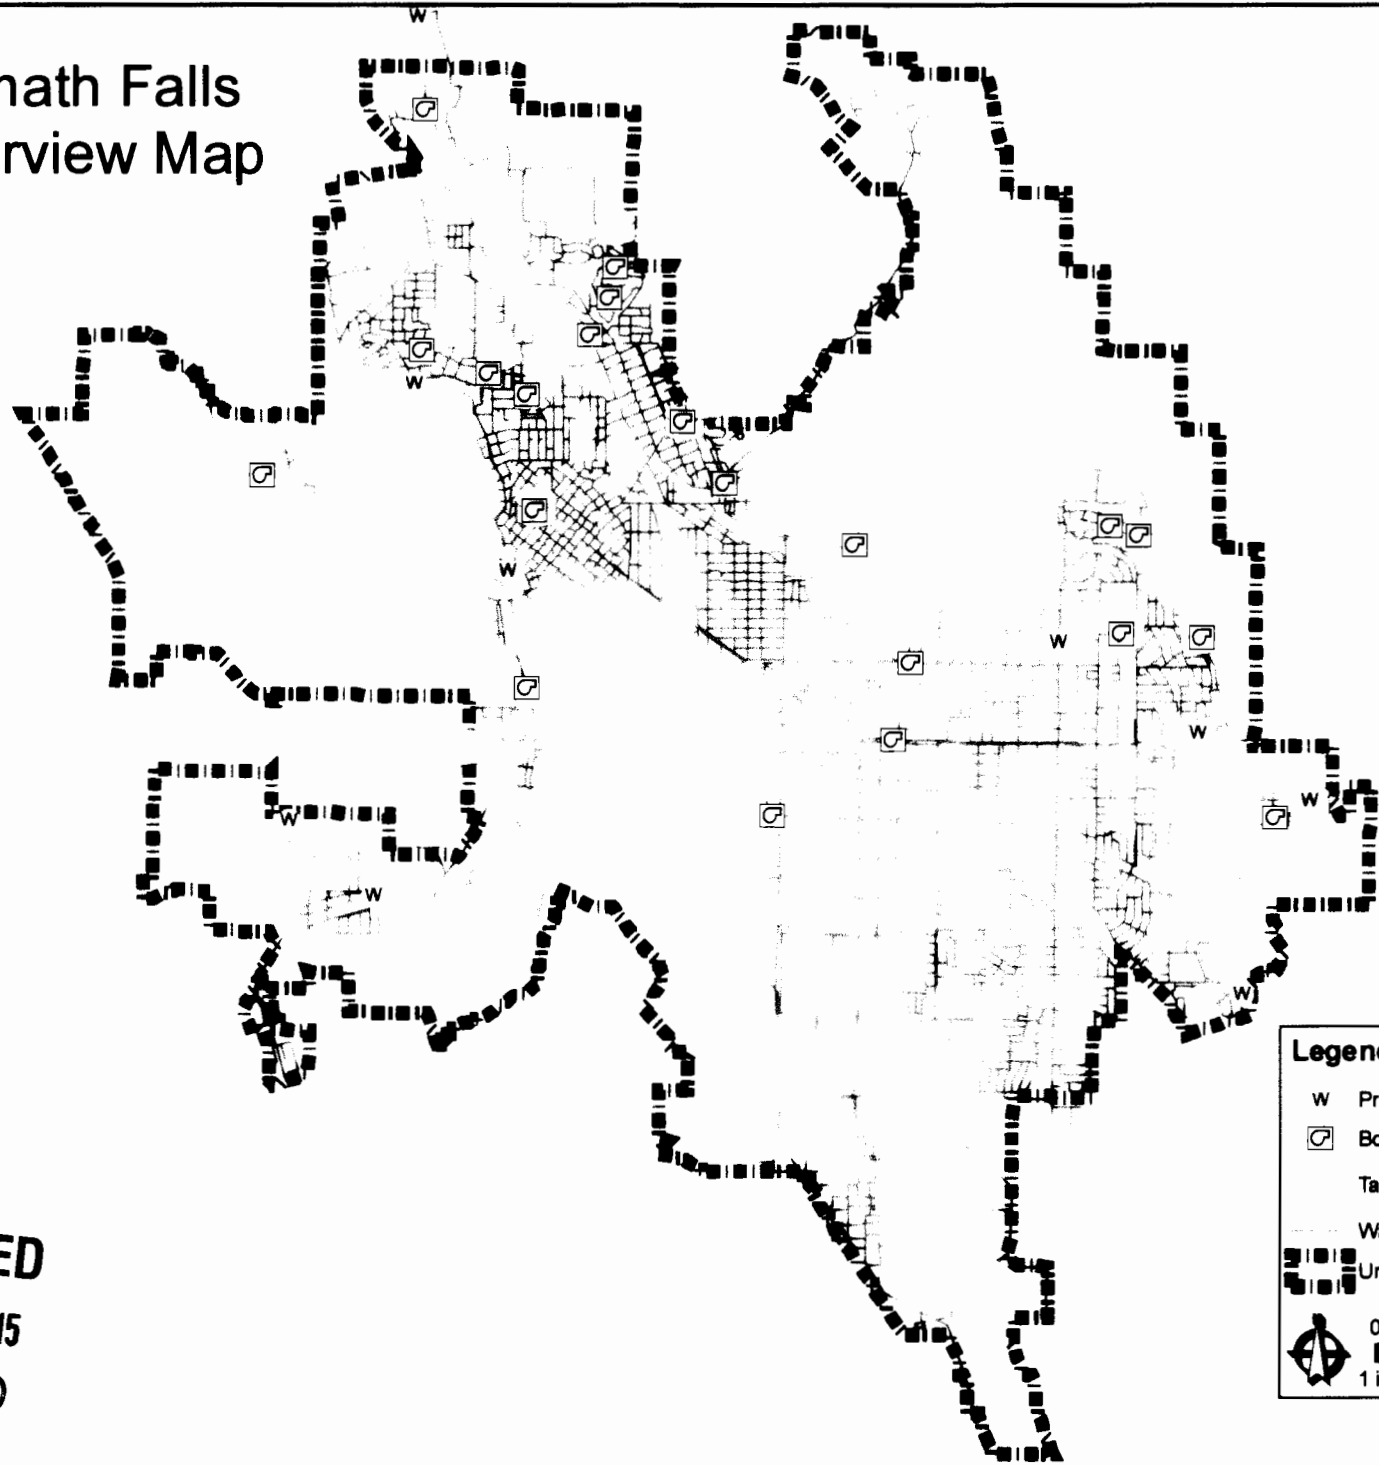

RECEIVED
MAY 14 2015
OWRD

Legend

- W Production Well
- ☐ (with circle) Booster Pump Station
- Tank/Reservoir
- Water Main Pipeline
- - - - Urban Growth Boundary

0 3,250 6,500
1 inch equals 6,500 feet