


CLAIM OF BENEFICIAL USE
 FOR REUEL PHILLIPS
 BY DUANE W. KIRBY
 T26S, R6W, SEC 33 WM
 TAX LOT 2200
 FISH SCREEN IS LOCATED AT THE POD
 SCALE 1" = 400'

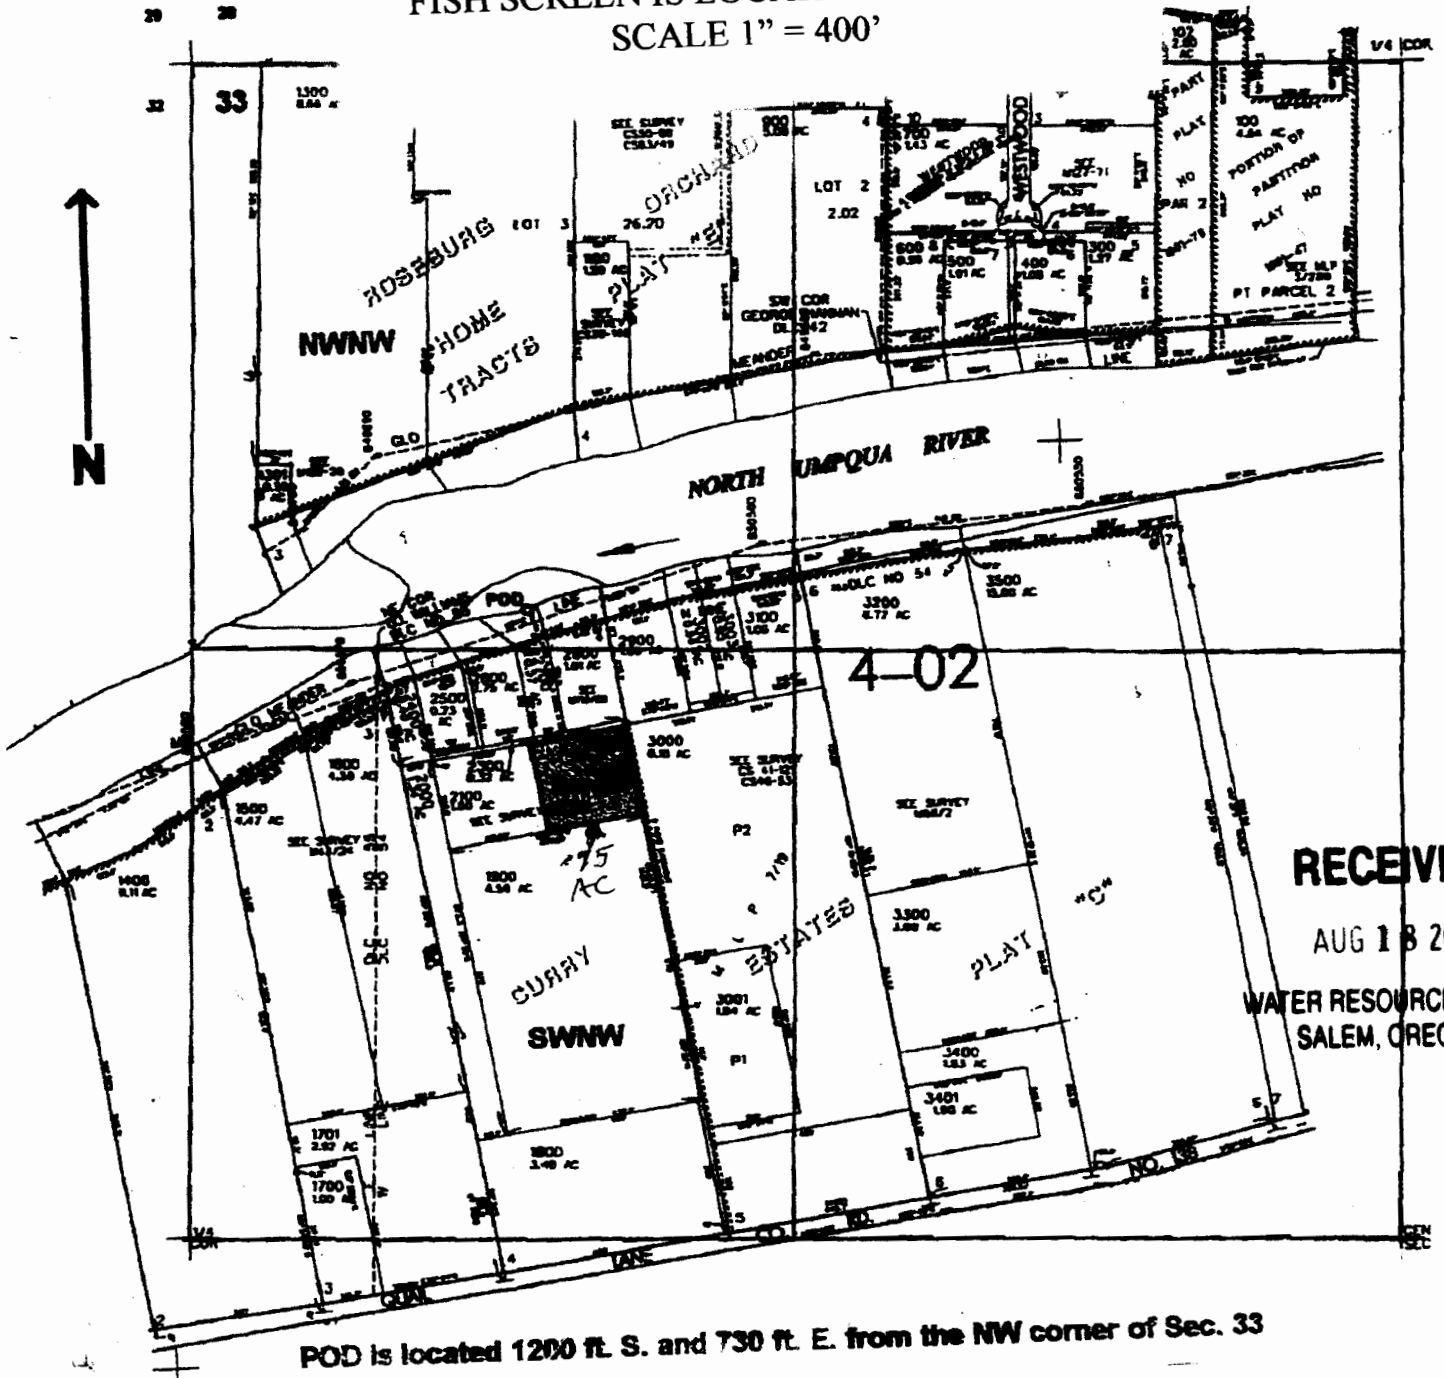

POD is located 1200 ft. S. and 730 ft. E. from the NW corner of Sec. 33

THE PURPOSE OF THIS MAP IS TO IDENTIFY THE LOCATION OF THE WATER RIGHT. IT IS NOT INTENDED TO PROVIDE INFORMATION RELATIVE TO THE LOCATION OF PROPERTY OWNERSHIP BOUNDARY LINES.

S-86219
 54285
 WRD
 8-28-09

