


T 3 S, R 5 W, WM  
YAMHILL COUNTY

PLAT 1234  
PAGE 10  
WATER RESOURCES DIVISION  
APRIL 19, 2010

TAX LOT:  
3 5 12 800

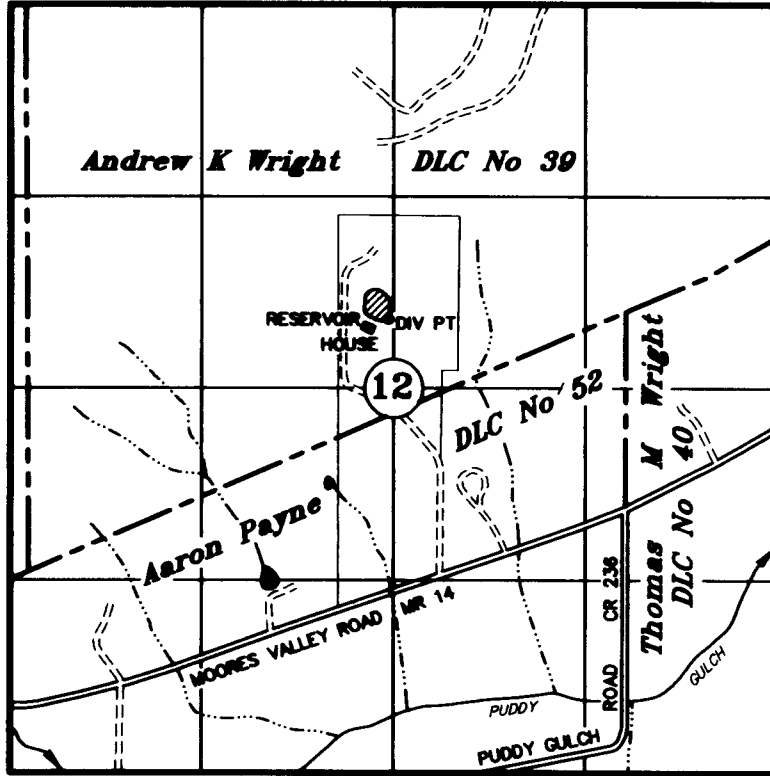

DIV PT: 30' S AND 1620' W OF THE NE CORNER AARON PAYNE DLC 52  
STAFF GAGE: 20' S AND 1630' W OF THE NE CORNER AARON PAYNE DLC 52  
(Staff Gage is mounted to the support shaft of the operating stem of the sluice gate.)


**FINAL PROOF SURVEY**

Application No. R-87562 UNDER Permit No. R-14847  
R-86469 R-14318

IN THE NAME OF

**Gary & Doris Hasson**

APRIL 19, 2010  
SCALE: 1" = 1320'

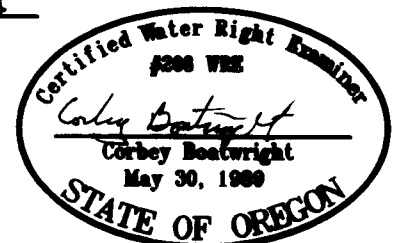

NOTE: This map is not intended to provide legal dimensions or locations of property ownership lines.

EXPIRES 12-31-11