


T 3 S, R 5 W, WM

YAMHILL COUNTY

TAX LOT:
3 5 12 800

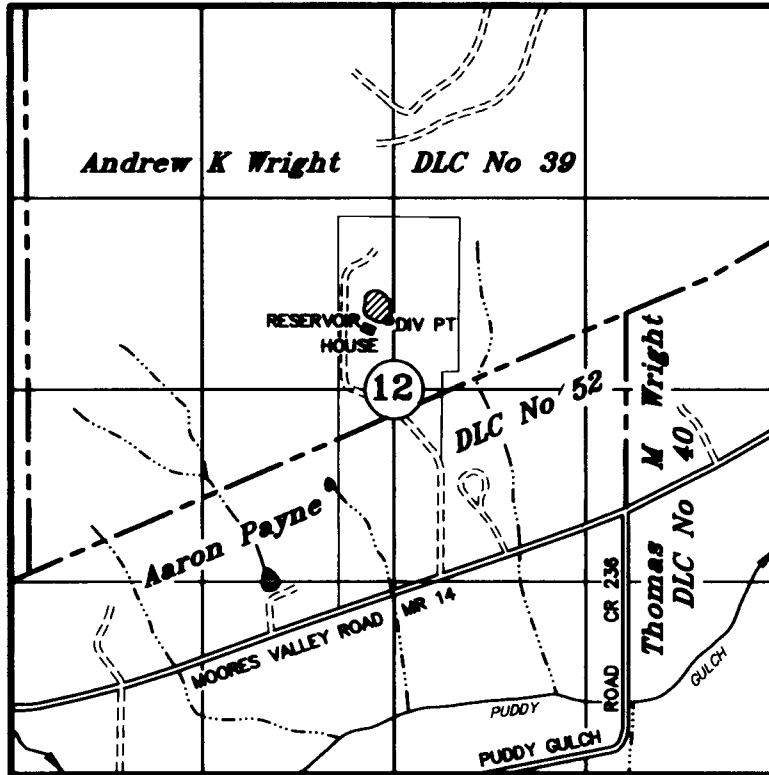

DIV PT: 30' S AND 1620' W OF THE NE CORNER AARON PAYNE DLC 52
STAFF GAGE: 20' S AND 1630' W OF THE NE CORNER AARON PAYNE DLC 52
(Staff Gage is mounted to the support shaft of the operating stem of the sluice gate.)

FINAL PROOF SURVEY


Application No. R-87562 UNDER Permit No. R-14847
R-86469 R-14318

IN THE NAME OF

Gary & Doris Hasson

APRIL 19, 2010

SCALE: 1" = 1320'

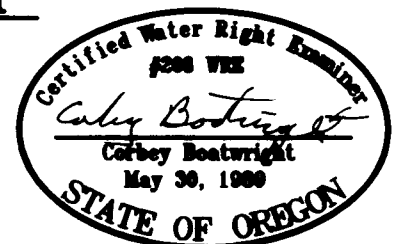

NOTE: This map is not intended to provide legal dimensions or locations of property ownership lines.

EXPIRES 12-31-11