


CLAIM OF BENEFICIAL USE FINAL PROOF MAP
LOCATED IN THE NE¼ NE¼ OF SECTION 29
TOWNSHIP 23 SOUTH, RANGE 10 WEST, W.M.
COOS COUNTY, OREGON
APPLICATION R-67736 PERMIT R-14417

1" = 400 FEET


PREPARED FOR: Oregon Department of Forestry
PREPARED BY: Dennis Goude
DATE PREPARED: February 26, 2008

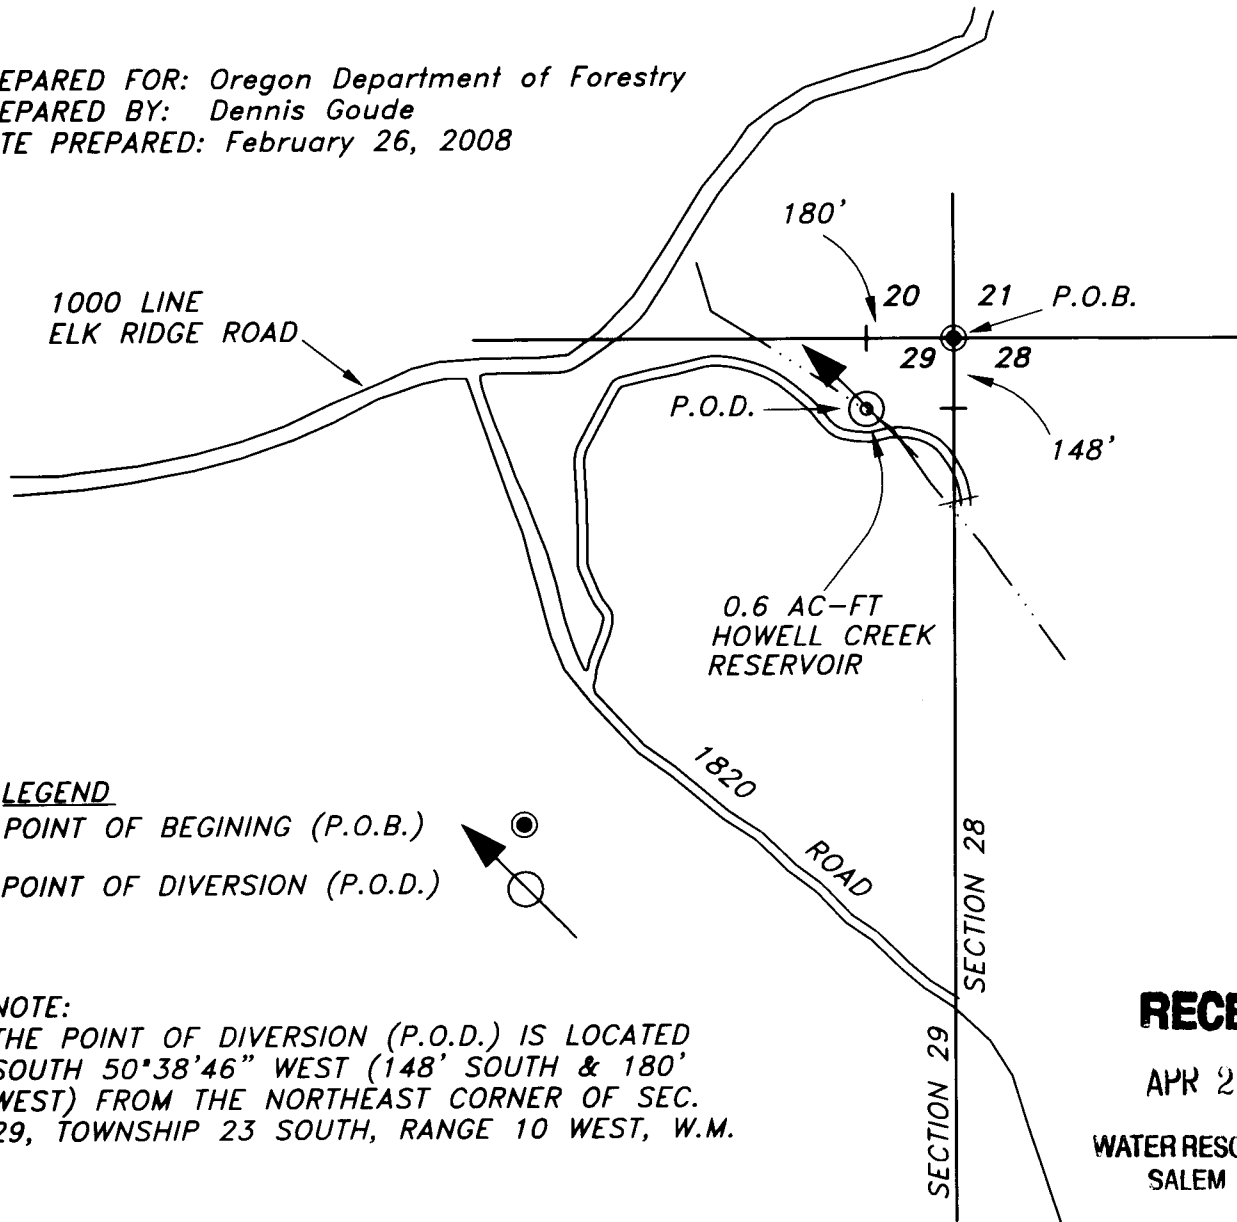

RECEIVED

APR 22 2008

WATER RESOURCES DEPT
SALEM OREGON

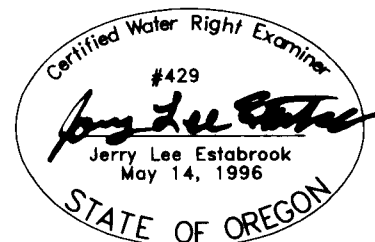

EXPIRES 12/31/2009

Stuntzner Engineering
& Forestry, L.L.C.

ENGINEERING • LAND SURVEYING • FORESTRY
PLANNING WATER RIGHTS

705 South 4th St. Phone: (541) 267-2872
Post Office Box 118 Coos Bay, Oregon 97420 Fax: (541) 267-0588

DISCLAIMER STATEMENT

The preparation of this map was for the purpose of identifying the location of the Water Right only and has no intent to provide dimensions or location of property ownership lines.