



SCALE: 1"=1320'

FINAL PROOF SURVEY


FOR: GARY MCMANUS
APPLICATION G-14833, PERMIT G-13659
PLACE OF USE OF WATER
USED FOR SUPPLEMENTAL IRRIGATION AND LOCATED
IN SECTION 29 TOWNSHIP 40 SOUTH,
RANGE 19 EAST OF THE
WILLAMETTE MERIDIAN, LAKE COUNTY, OREGON

REVISION	BY







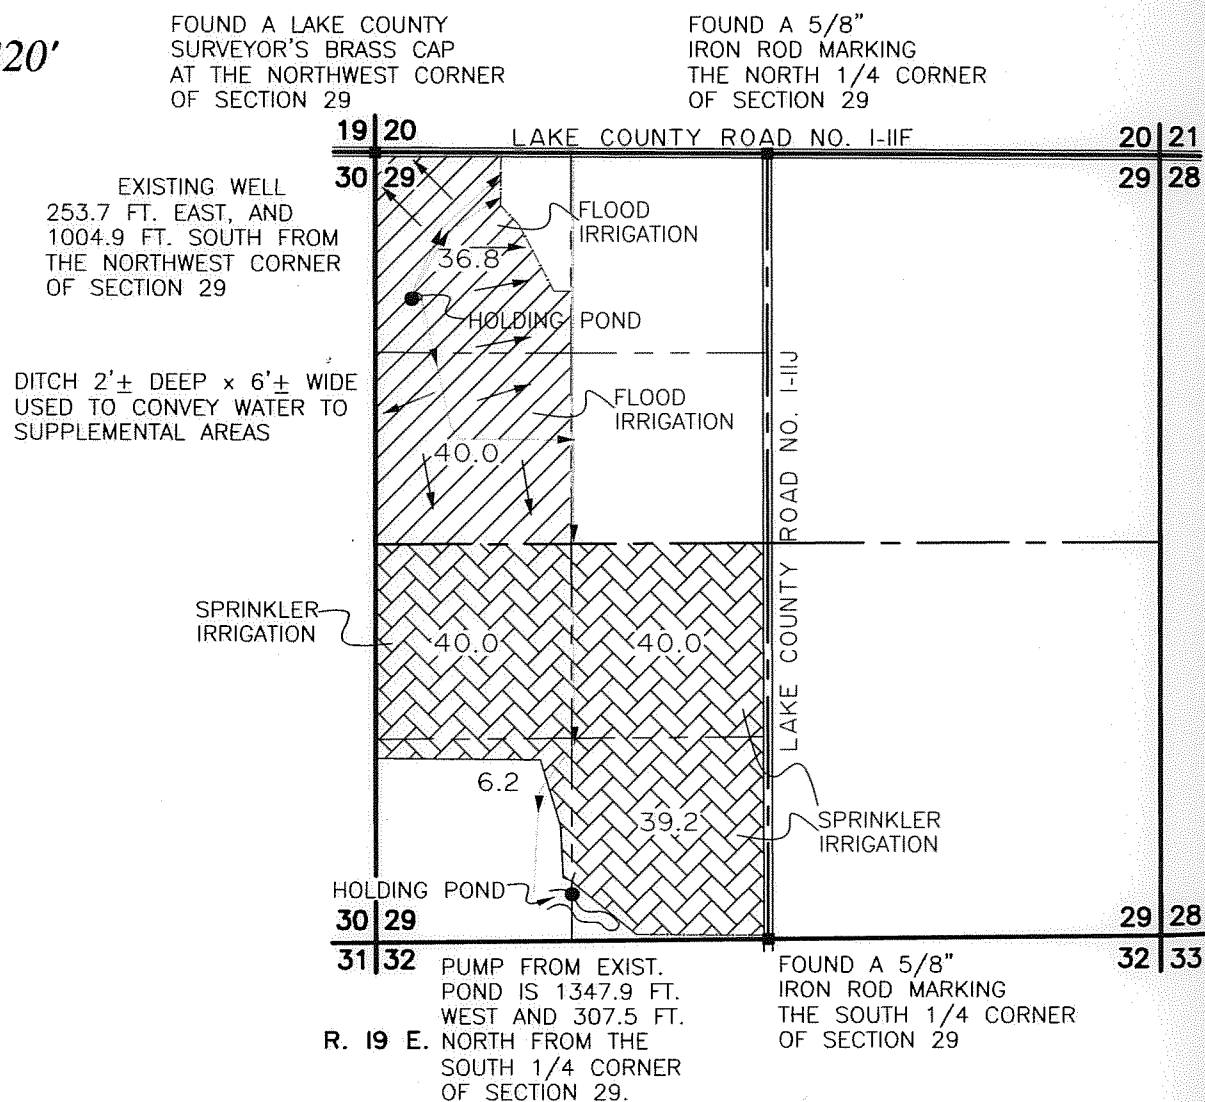



ANDERSON ENGINEERING AND SURVEYING, INC.
 P.O. BOX 28
 LAKEVIEW, OREGON 97630
 (541) 947-4407
 FAX 947-2321

P.O. BOX 419
 REDMOND, OREGON 97756
 (541) 923-4307
 FAX 923-4308

RECEIVED
 SEP 27 2001
 WATER RESOURCES DEPT
 SALEM, OREGON




LEGEND

-  76.8 ACRES SUPPLEMENTAL WATER
-  125.4 ACRES SUPPLEMENTAL TO MAKE UP DEFICIENCY IN RATE
-  SECTION LINE
-  1/4 SECTION LINE
-  1/16 SECTION LINE
-  GOVERNMENT LOT LINES
-  EXISTING FENCE
-  EXISTING DITCH
-  EXISTING POINT OF DIVERSION OR APPROPRIATION
-  FOUND LAND SURVEY MONUMENT AS NOTED

SEE ACCOMPANYING
SITE REPORT

NOTE: PREPARATION OF THIS MAP IS FOR IDENTIFYING PROPOSED WATER RIGHTS ONLY. IT HAS NO INTENT TO PROVIDE LOCATIONS OR DIMENSIONS OF PROPERTY BOUNDARIES.

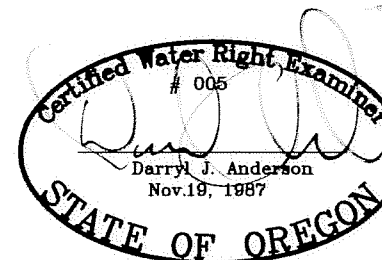

RENEWAL 12/31/2001

PREPARED FOR:
 GARY MCMANUS
 HC 60 BOX 3310
 LAKEVIEW, OREGON 97630

DATE: 7/10/2001
SCALE: 1"=1320'
JOB: 2001_30
DWG. BY:
FILE: 2130FP
SHEET 1 OF 1