
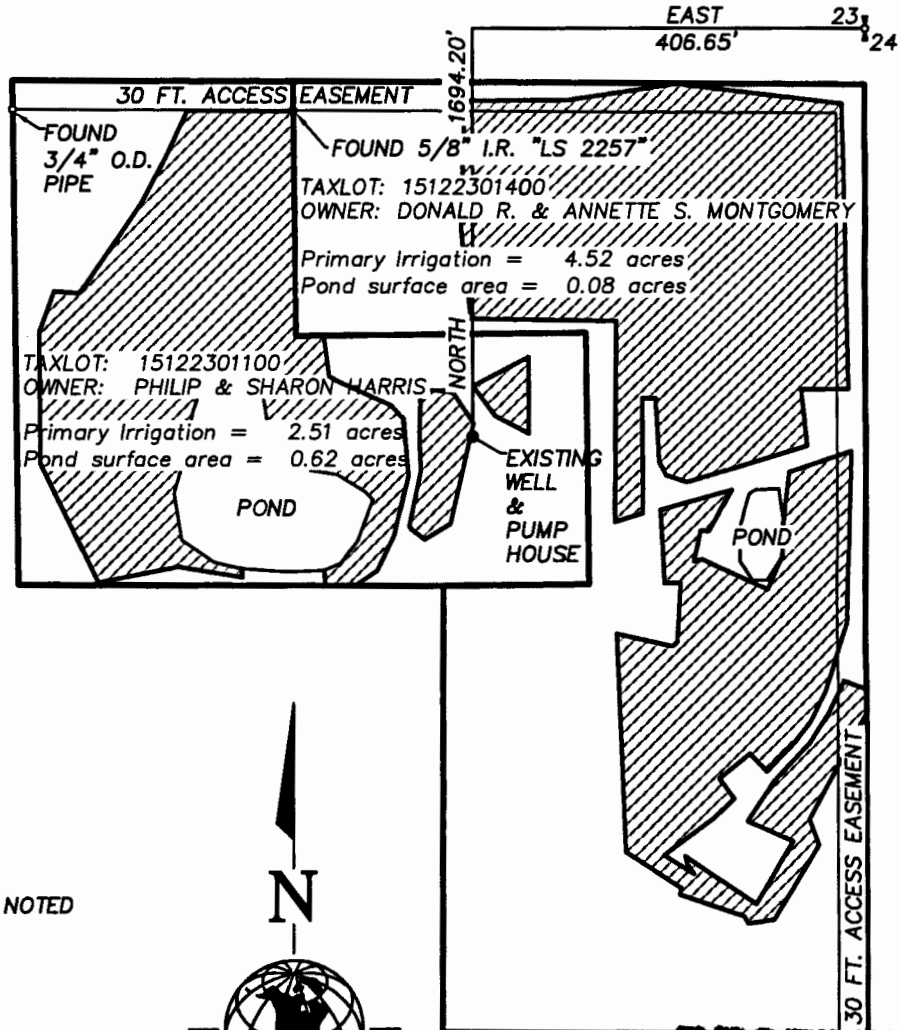


FINAL PROOF SURVEY
LOCATED IN THE SOUTHEAST 1/4 OF THE SOUTHEAST 1/4 OF SECTION 23,
TOWNSHIP 15 SOUTH, RANGE 12 EAST, WILLAMETTE MERIDIAN,
DESCHUTES COUNTY OREGON
APPLICATION NO. G-12742 PERMIT NO. G-12142
IN THE NAME OF: DON MONTGOMERY
SEPTEMBER, 2005

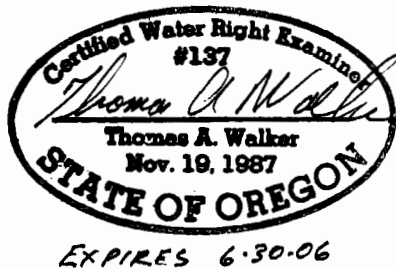

AREA SUMMARY

PRIMARY IRRIGATION = 7.03 ACRES
POND SURFACE AREA = 0.70 ACRES

LEGEND


- FOUND SURVEY MONUMENT AS NOTED
- ⊕ EXISTING WELL
- EXISTING POND
- ▨ PRIMARY IRRIGATION

NOTE:

1. APPROXIMATE PROPERTY BOUNDARIES AND SECTIONAL TIES SHOWN ON THIS SURVEY WERE GENERATED FROM DESCHUTES COUNTY RECORDS CS11968 BY W&H PACIFIC.
2. THE PURPOSE OF THIS DRAWING IS TO LOCATE A WATER RIGHT ONLY AND IS NOT INTENDED TO PROVIDE THE LOCATION OF PROPERTY LINES OR LEGAL DIMENSIONS.



RECEIVED
SEP 29 2005
WATER RESOURCES DEPT
SALEM OREGON

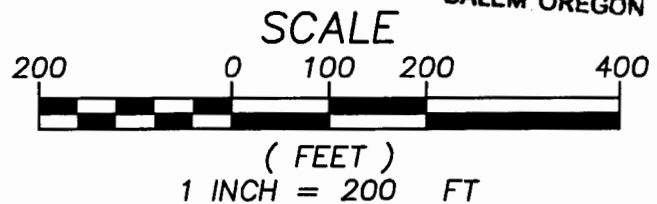

DESIGNED BY:		CHECKED BY:	TW	
DRAWN BY:	ANH	APPROVED BY:	TW	
LAST EDIT:	9/08/05	PLOT DATE:	09/16/05	
DATE	BY	REV#	REVISION	CK'D/APP'R



DON MONTGOMERY GROUND WATER RIGHTS FINAL PROOF SURVEY			
REDMOND/DESCHUTES		OREGON	
SCALE: 1"=200'	PROJECT NO. 31845	DRAWING FILE NAME: MONTG-WR-BASE	SHEET 1 of 1