

☐ MINOR
☒ MAJOR


partition

lane county



M 275-79

SUMMARY

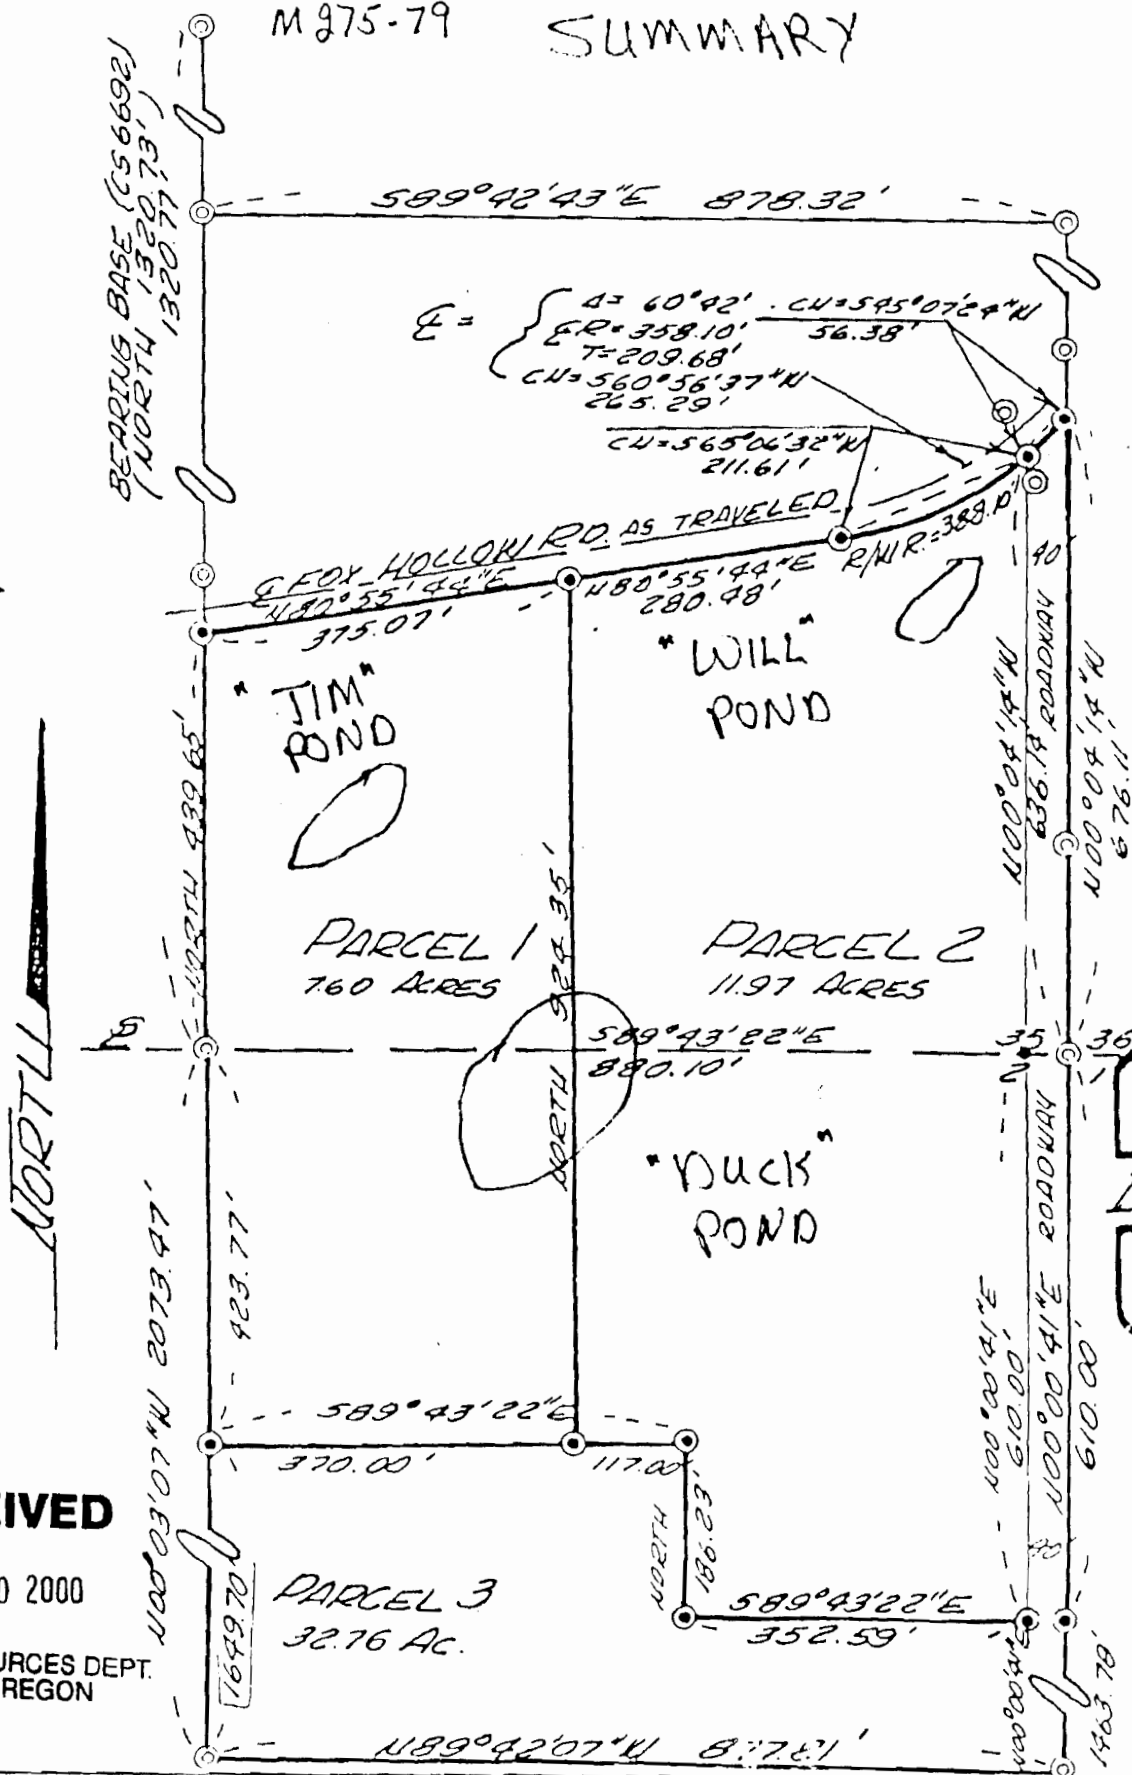

REGISTERED
PROFESSIONAL
LAND SURVEYOR

David S. Swan

OREGON
DAVID S. SWAN
1103

Application No. 84479
 Permit No. 84479

RECEIVED

JUN 30 2000

WATER RESOURCES DEPT.
SALEM, OREGON

SCALE: 1" = 200'

FILE NO:

TRAINING DIVISION / ENVIRONMENTAL MANAGEMENT DEPARTMENT / 125 EAST 8TH AVE / EUGENE, OR 97401 / PHONE (503) 681-1111