


SECTION 10, T.4S, R.1E, W.M.
CLACKAMAS COUNTY, OREGON

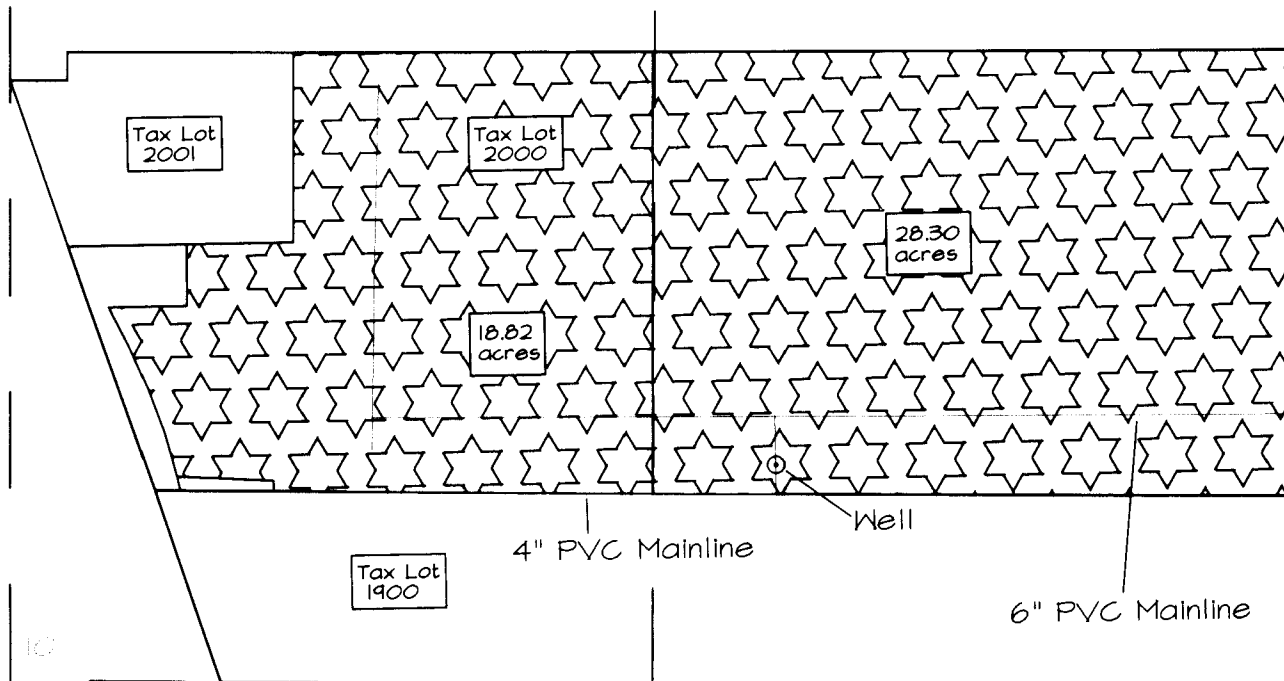

SCALE: 1" = 400'

THE WELL IS 1591 FEET EAST AND 454 FEET NORTH OF THE SW CORNER OF SECTION 10
THE WATER METERS ARE LOCATED AT THE WELL.

1/4 CORNER
BETWEEN
SECTIONS 10 & 15



IRRIGATED AREA
(47.12 ACRES)


RECEIVED

DEC 26 2007

WATER RESOURCES DEPT
SALEM, OREGON

CLAIM OF BENEFICIAL USE MAP
ALLEN KRAXBERGER, JR.

APPLICATION NO. G-15057
PERMIT NO. G-13814

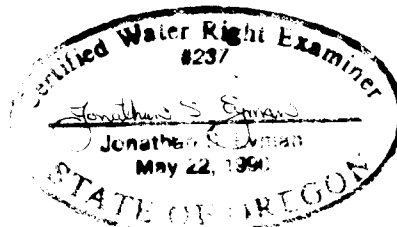

THE PREPARATION OF THIS MAP IS FOR THE
PURPOSE OF IDENTIFYING THE LOCATION
OF THE WATER RIGHT ONLY AND HAS NO
INTENT TO PROVIDE DIMENSIONS OR LOCATION
OF PROPERTY OWNERSHIP LINES

C:\SOLO\9300\CLIENT 12/2007

RECEIVED 12-31-2007