


CLAIM OF BENEFICIAL USE
 FOR DAVID H, AND JILL G. COOPER
 BY: DUANE W. KIRBY
 T28S, R7W, SEC 27 & 34 WM
 APPLICATION NO S-86217
 PERMIT NO S-54206
 DOUGLAS COUNTY
 METER IS LOCATED 100 FEET FROM POD
 FISH SCREEN IS LOCATED AT THE POD

RECEIVED

MAY 13 1989

WATER RESOURCES DEPT
 SALEM, OREGON

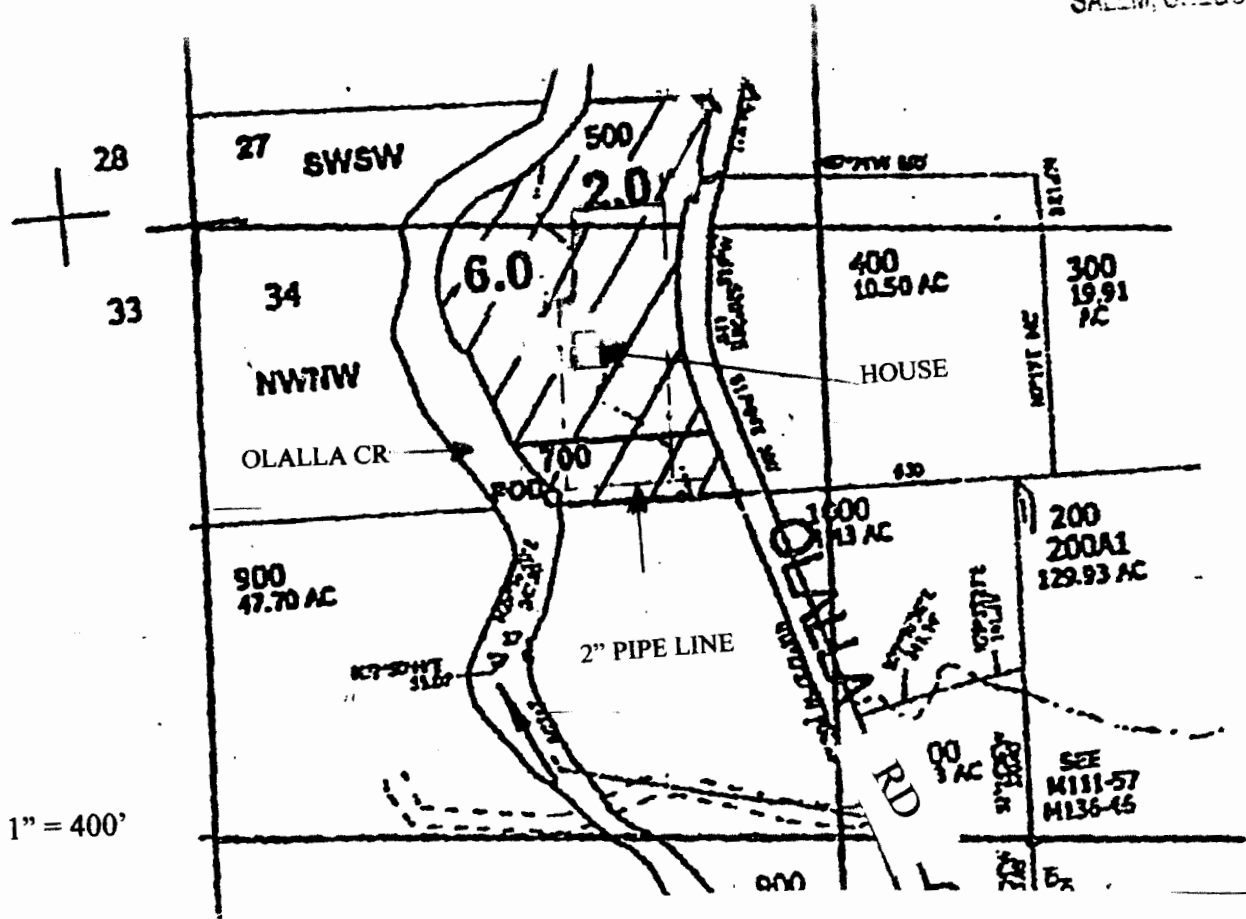

POD IS LOCATED 600 FT SOUTH AND 730 FT EAST
 FROM THE NW CORNER OF SEC 34

THE PURPOSE OF THIS MAP IS TO
 IDENTIFY THE LOCATION OF THE
 WATER RIGHT. IT IS NOT INTENDED
 TO PROVIDE INFORMATION RELATIVE
 TO THE LOCATION OF PROPERTY
 OWNERSHIP BOUNDARY LINES.

