


0390

CLAIM OF BENEFICIAL USE MAP
APPLICATION G-15711 PERMIT G-15529
FOR
RUSSELL AND NORA JUNCAL
1965 HILTON ROAD
HORN BROOK, CA 96044
SITUATED IN
DLC NO. 38
TOWNSHIP 41 SOUTH, RANGE 2 EAST, WILLAMETTE MERIDIAN
JACKSON COUNTY, OREGON
AND
FRACTIONAL SECTION 14
TOWNSHIP 48 NORTH, RANGE 7 WEST, MT. DIABLO MERIDIAN
SISKIYOU COUNTY, CALIFORNIA

Source: Well No. Jack 21247
Bears South 63.00' and West
128.00' from N.E. Cor., DLC 37

Note: Storage tank and flow meter located at well,
inside building. Easement for well, pipeline
and application of water contained in Grant
Deed 97003834, Siskiyou County, California and
Document 87-012741, Jackson County, Oregon.

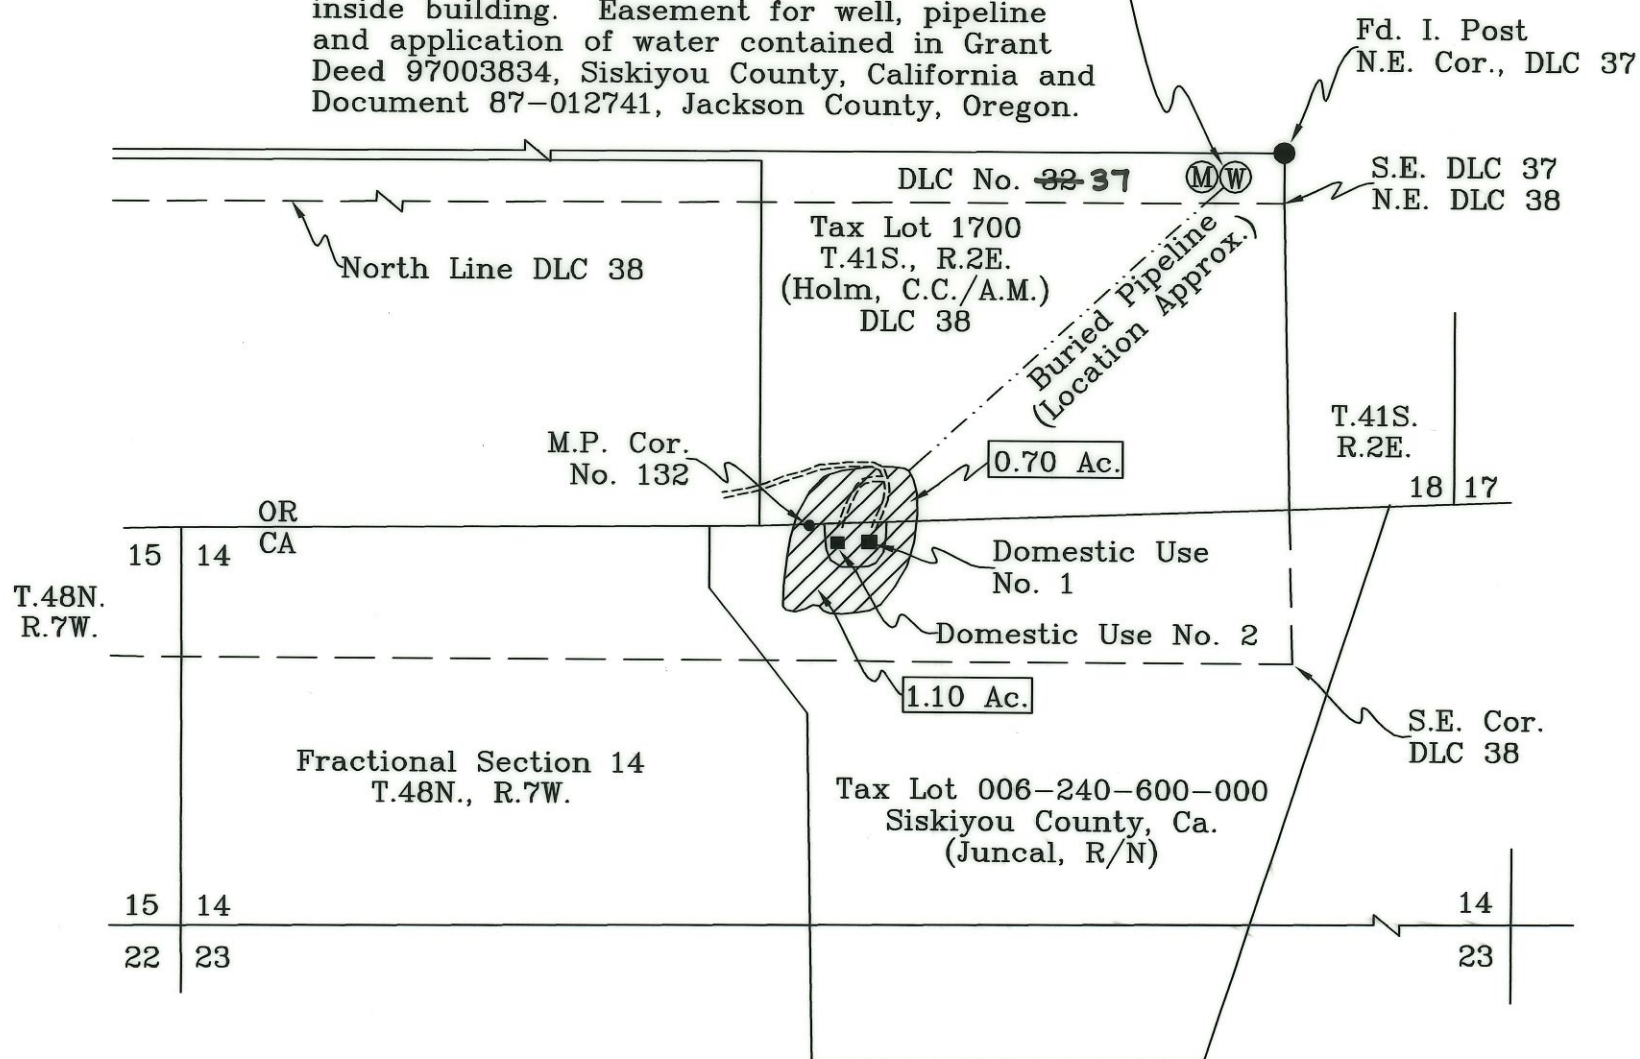


Scale: 1"=400' 500' JC/WRD
12/7/2021

LEGEND

- Found Survey Monument
- Denotes Structure/Building
- Denotes Driveway
- - - - Denotes Buried Pipeline
- (M) Denotes Flow Meter
- ▨ Denotes Area Being Irrigated

This map was prepared for the purpose of
identifying the location of a water right only
and is not intended to provide legal dimen-
sions or location of property ownership.

Note: Storage tank and flow meter
located at well inside building.

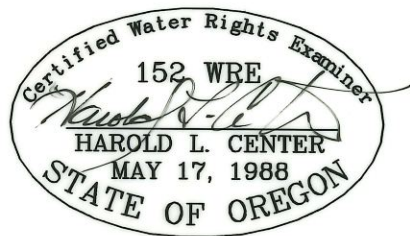

HAROLD L. CENTER
2604 David Lane
Medford, OR. 97504
Phone 541-535-6108
Oregon Certificate No. 152
Certificate Renewal Date: 12/31/2009

RECEIVED

NOV 03 2008

WATER RESOURCES DEPT
SALEM, OREGON

Project 08-14