


SECTION 35, TWP.3 N. RANGE 17 E. W.M.
SHERMAN COUNTY, OREGON

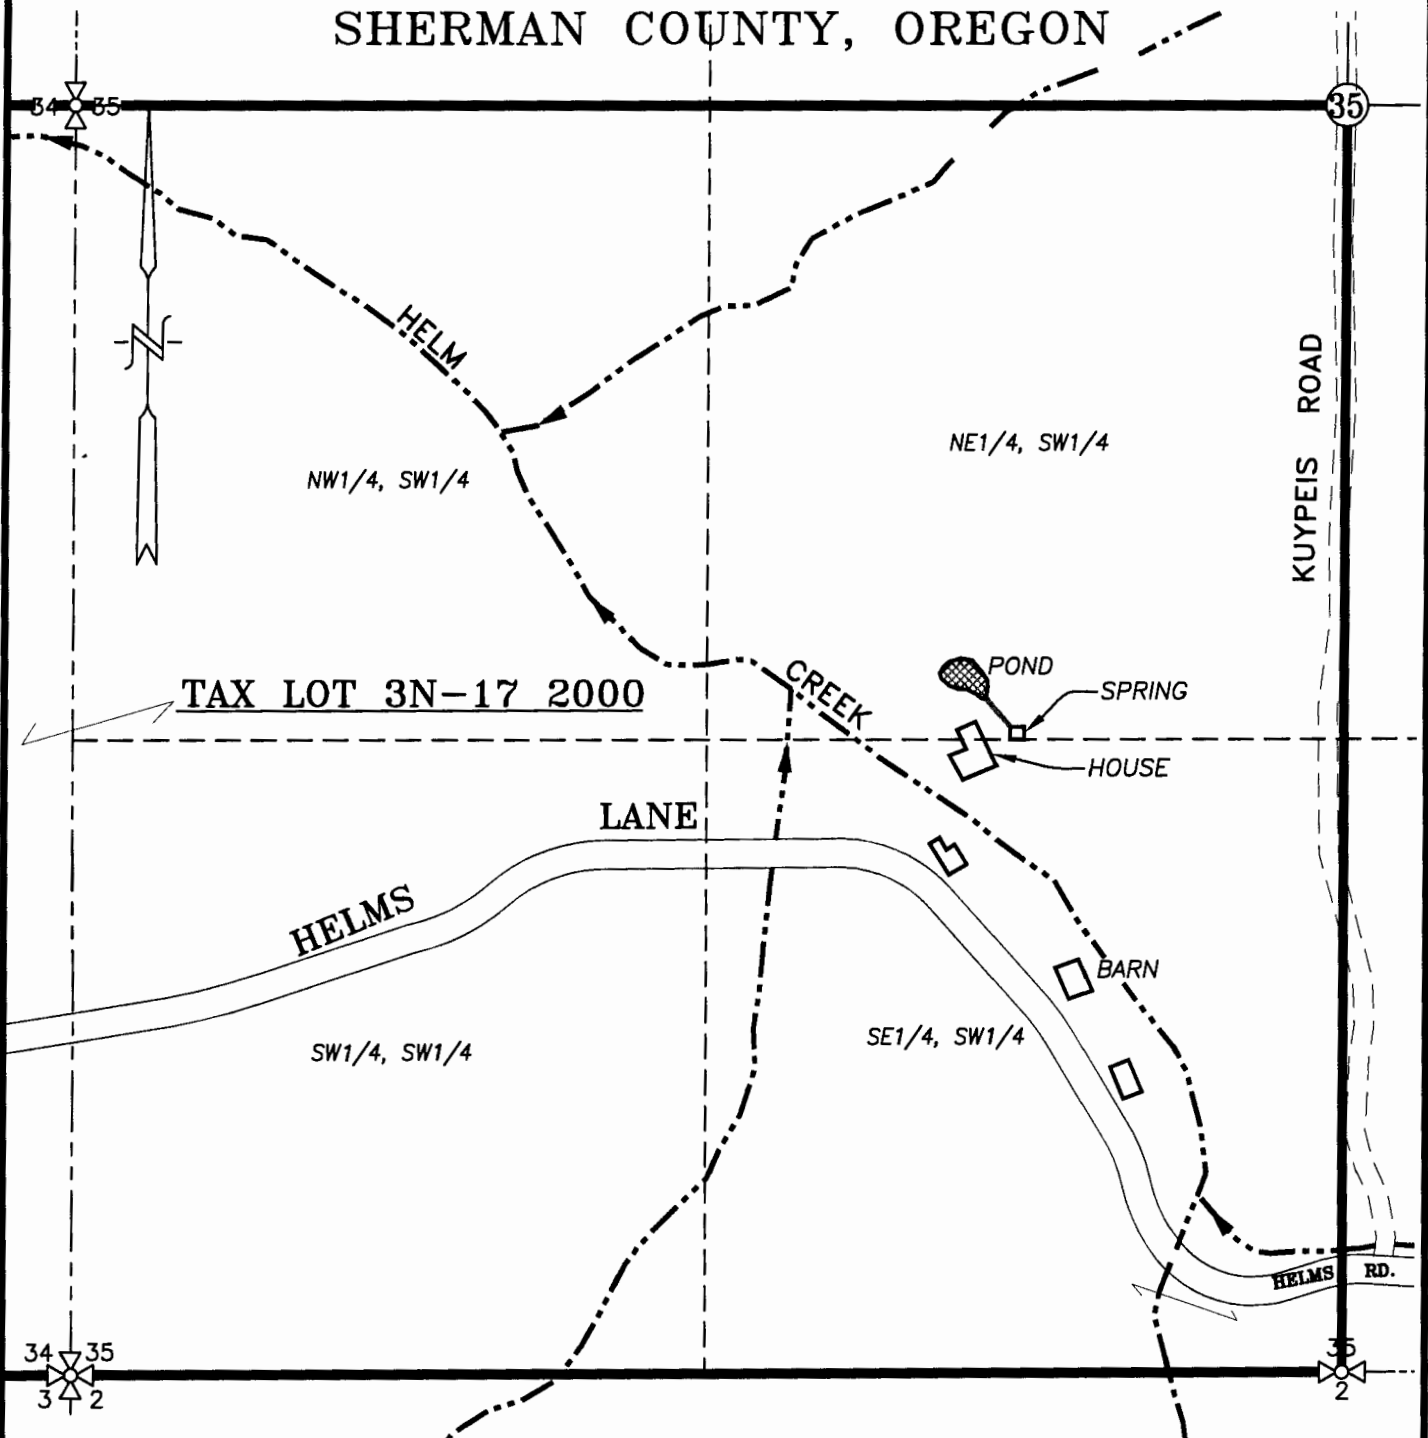


LEGEND:

- POND: 1450' N. & 1800' E. OF SW COR. SEC. 35
~.~.~ STREAM WITH DIRECTIONAL FLOW

CLAIM MAP

SCALE: 1" = 400'

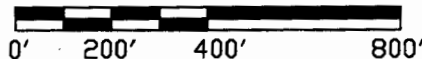

APPLICATION No. R-87779

PERMIT No. R-14969

IN THE NAME OF:

REID RANCH, LLC AND SETLZER/JOHNSON TRUST

DATE: SEPTEMBER 11, 2014

BY: **TENNESON ENGINEERING CORP.**

3775 CRATES WAY
THE DALLES, OREGON. 97058
PH. 541-296-9177
FAX 541-296-6657



EXPIRES: 06/30/2016

NOTE:

"THIS MAP IS NOT INTENDED TO
PROVIDE DIMENSIONS OR LOCATIONS
OF PROPERTY OWNERSHIP LINES."

W.O. #14412wr