


Lakeview Estates Homeowner's Association

1" = 1320'

Tax Lot: 3800



10 South, 4 West, Section 26

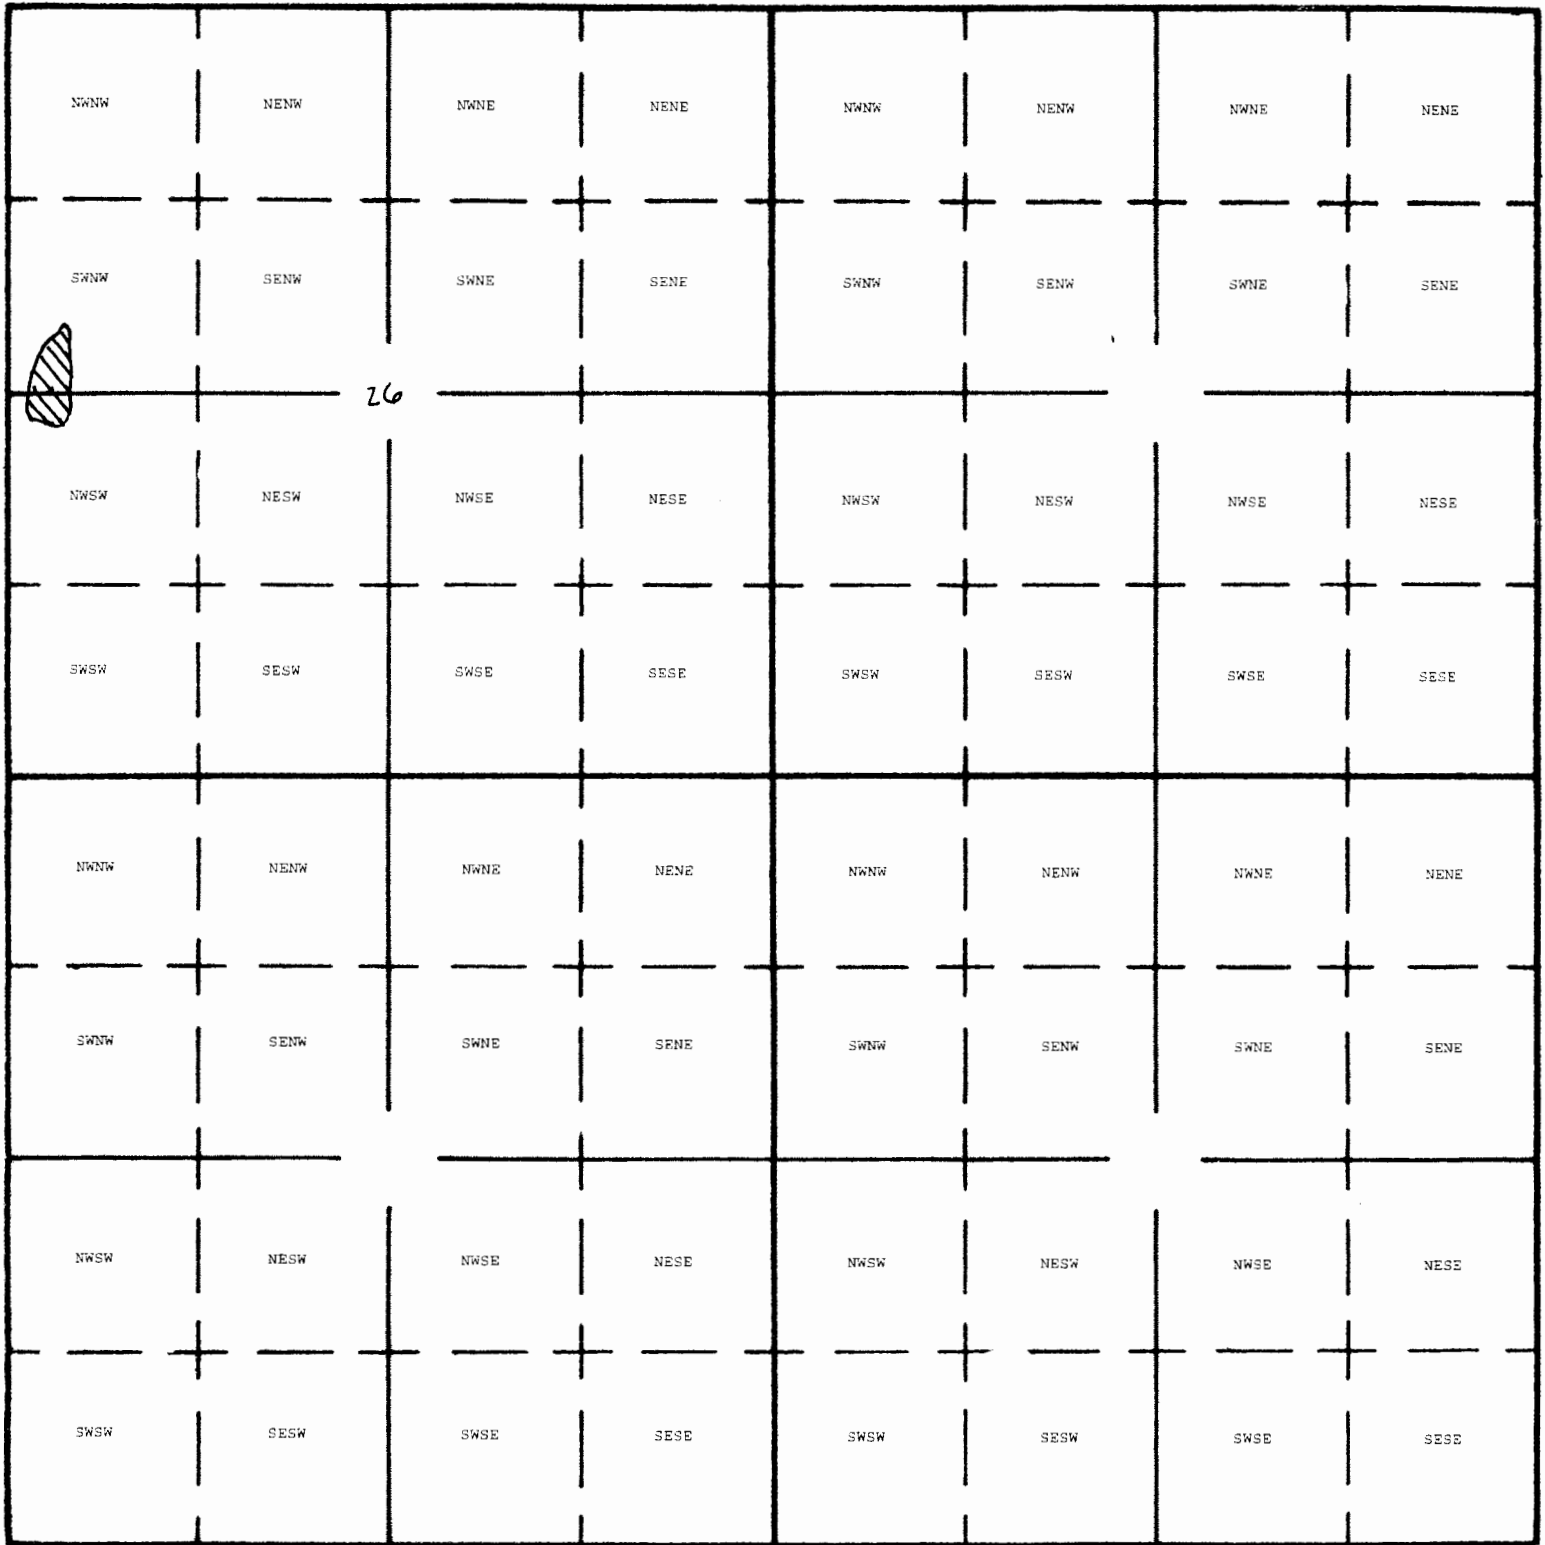

South

RECEIVED BY OWRD

Dam Location: 230 Feet South and 280 Feet East from W1/4 of Section 26

MAY 11 2014

SALEM, OR

RS R-87981
PERMIT R-15076

RECEIVED BY OWRD

OCT 17 2014

SALEM, OR