


Arthur and Jerre Woody Reservoir Application Map

SEC.6 T.27S. R.4W. W.M.
DOUGLAS COUNTY
SCALE 1' = 500'

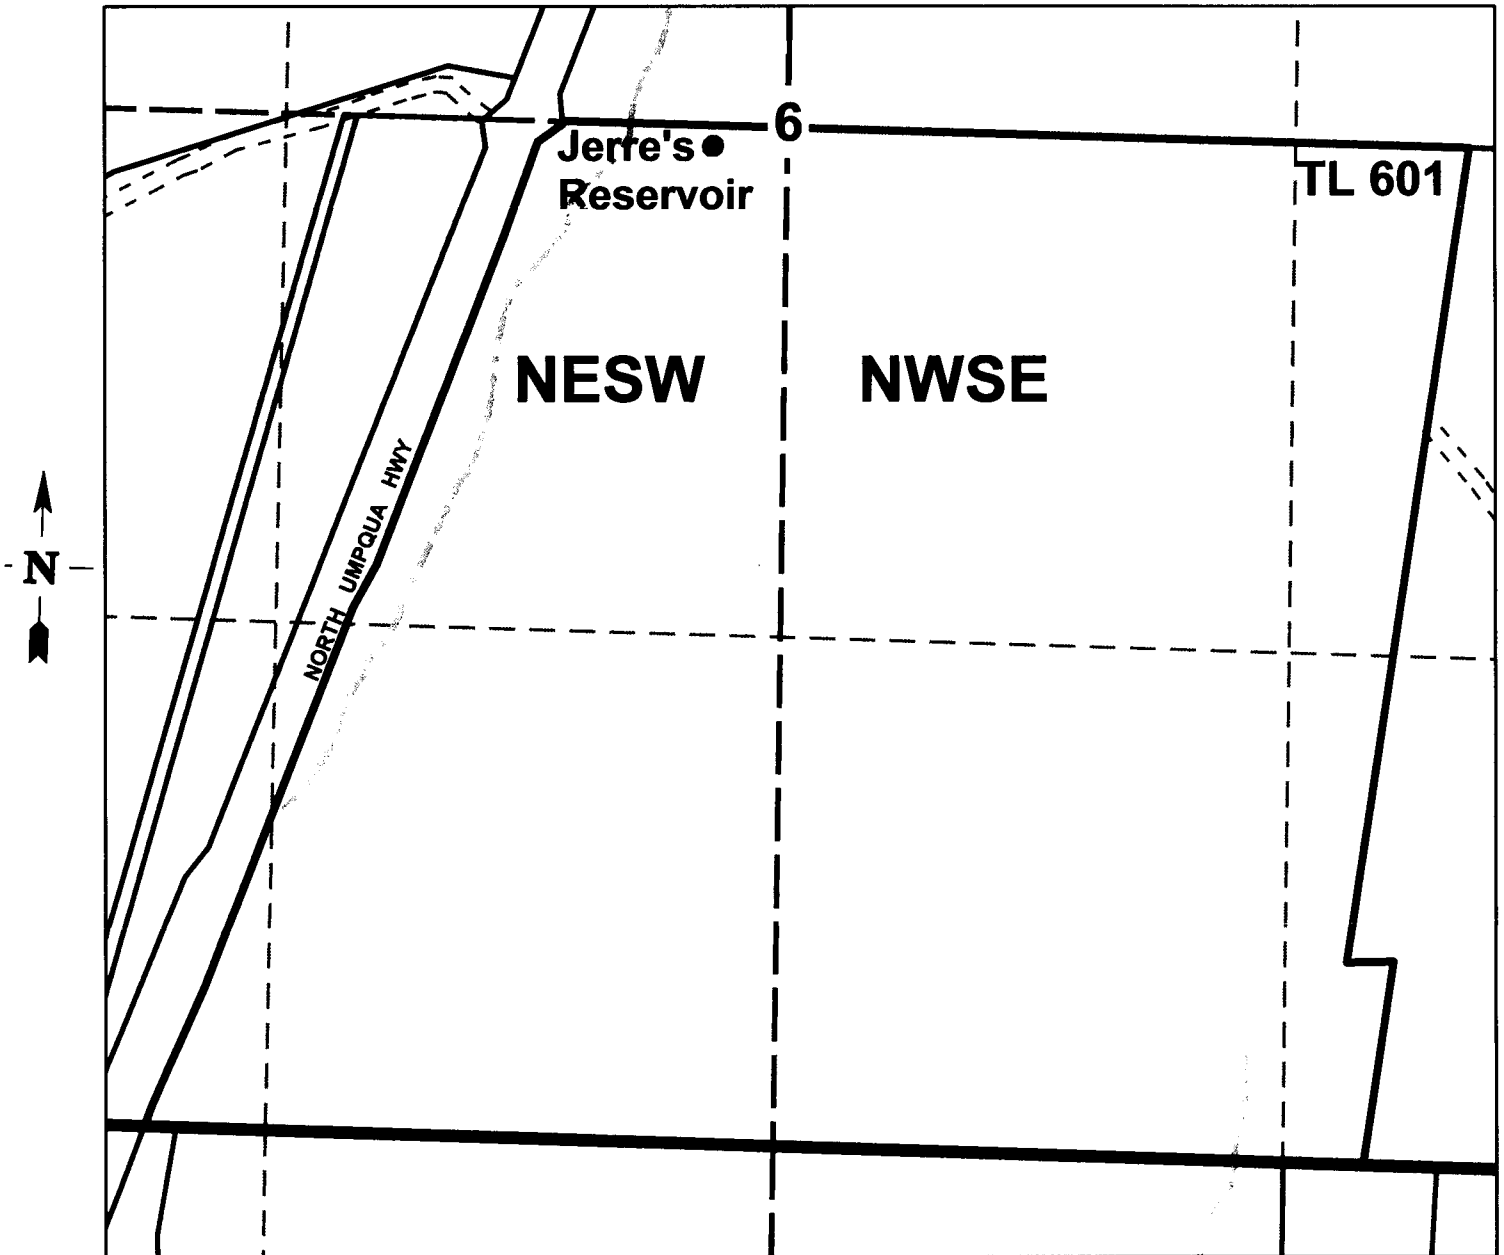

Reservoir is located 25 ft. south and 165 ft. west from the
center of Section 6.

RECEIVED BY OWRD

OCT 23 2013

SALEM, OR