

CLAIM OF BENEFICIAL USE MAP

Located in SE $\frac{1}{4}$ SW $\frac{1}{4}$ Section 7
T40S, R13W, Willamette Meridian
Curry County, Oregon



Application #S-86641-Permit #S-54448

In the name of Glen Horton

Date: December 11, 2009

EXAMINERS DISCLAIMER STATEMENT

The preparation of this map was for the purpose of identifying the location of the Water Right only and has no intent to provide dimensions or location of property ownership lines.

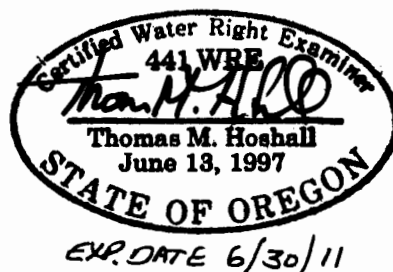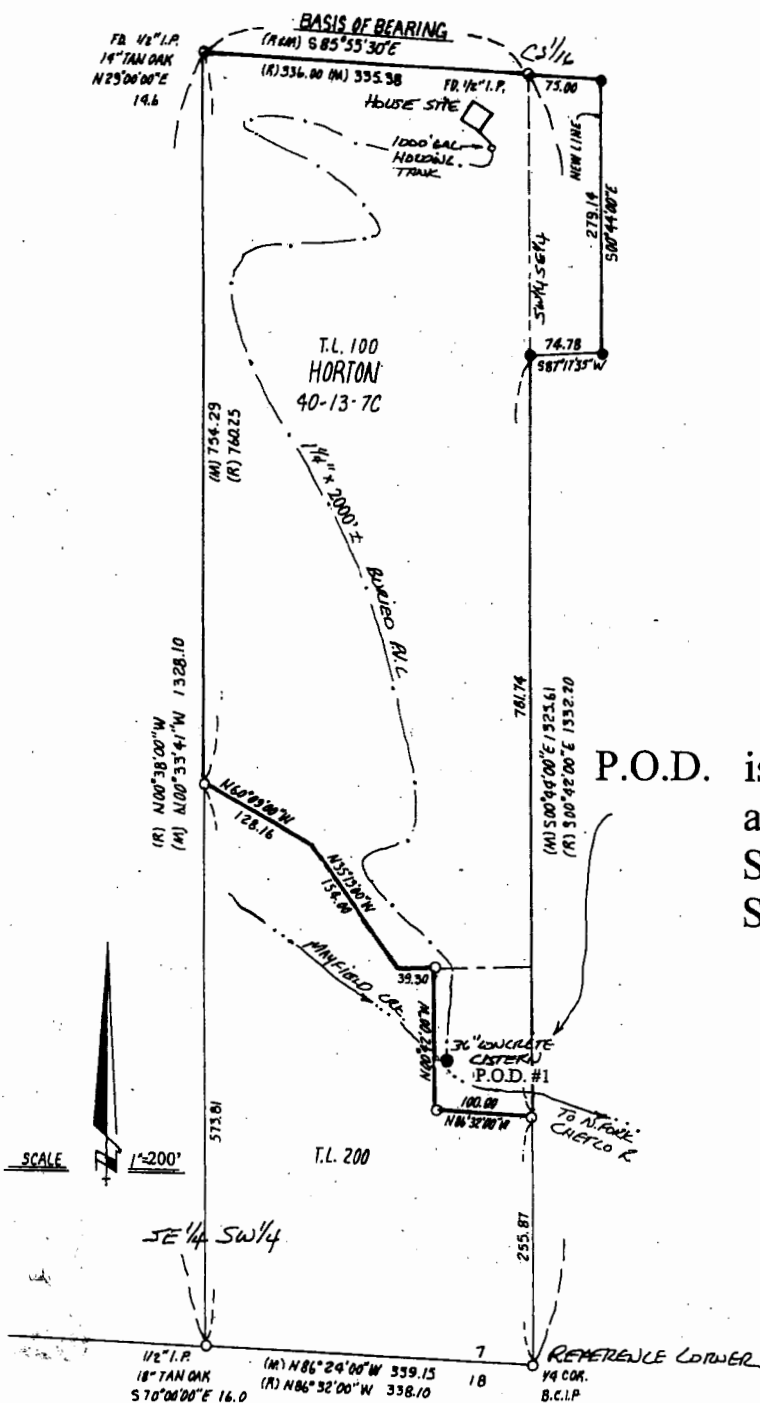

RECEIVED

DEC 28 2009

WATER RESOURCES DEPT
SALEM, OREGON

P.O.D. is 335.7 ft. North
and 98.2 ft. West of the
South $\frac{1}{4}$ Corner of
Section 7, T40S, R13W W. M.

LEGEND

- MONUMENTS FOUND (AS NOTED)
- SET 5/8" X 30" IRON ROD w/YELLOW PLASTIC CAP STAMPED P.L.S. 1868
- CALCULATED POSITION ONLY
- (M) MEASURED
- (R) RECORD

— "PVC PIPELINE

— CREEK