

SECTION 34 T.19S. R.12W. W.M.

NORTH 1/4 CORNER SECTION 34

NORTH LINE OF SECTION 34

CENTER LINE OF SECTION 34

POINT OF DIVERSION:
S 1698' E 828'
N 1/4 COR. SEC. 34
PUMP WITH FISH SCREEN


1" PVC WATER MAIN

TSILTCOOS LAKE

LAKE BLVD.

CHERRY STREET

LOT 3

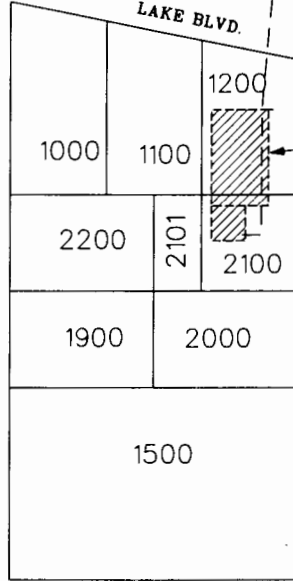

HOUSE

1300

SUMMIT STREET



FINAL PROOF MAP

1" = 100'

IN THE SW 1/4 OF NE 1/4
OF SECTION 34,
T.19S. R.12W. W.M.
LANE COUNTY, OREGON
BASIN 18

BY:


MIKE McALLISTER ENGINEERING
 11301 E. MAPLETON ROAD
 MAPLETON, OREGON 97453
 PH: 541-268-4326
 FAX: 541-268-4326

NOTE:
THIS MAP IDENTIFIES THE LOCATION OF THE
WATER RIGHT ONLY, AND IS NOT INTENDED TO PROVIDE
DIMENSIONS OR LOCATE PROPERTY OWNERSHIP LINES.

APPLICATION No. S-87161
PERMIT No. S-54546

GEORGE BURKE

MARCH 18, 2010

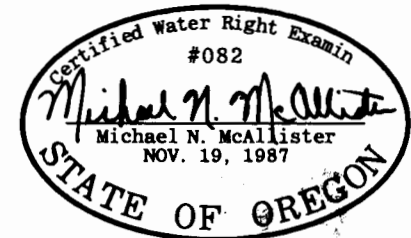

RECEIVED
 WATER RIGHTS DIVISION
 LANE COUNTY, OREGON
 10/18/2010