


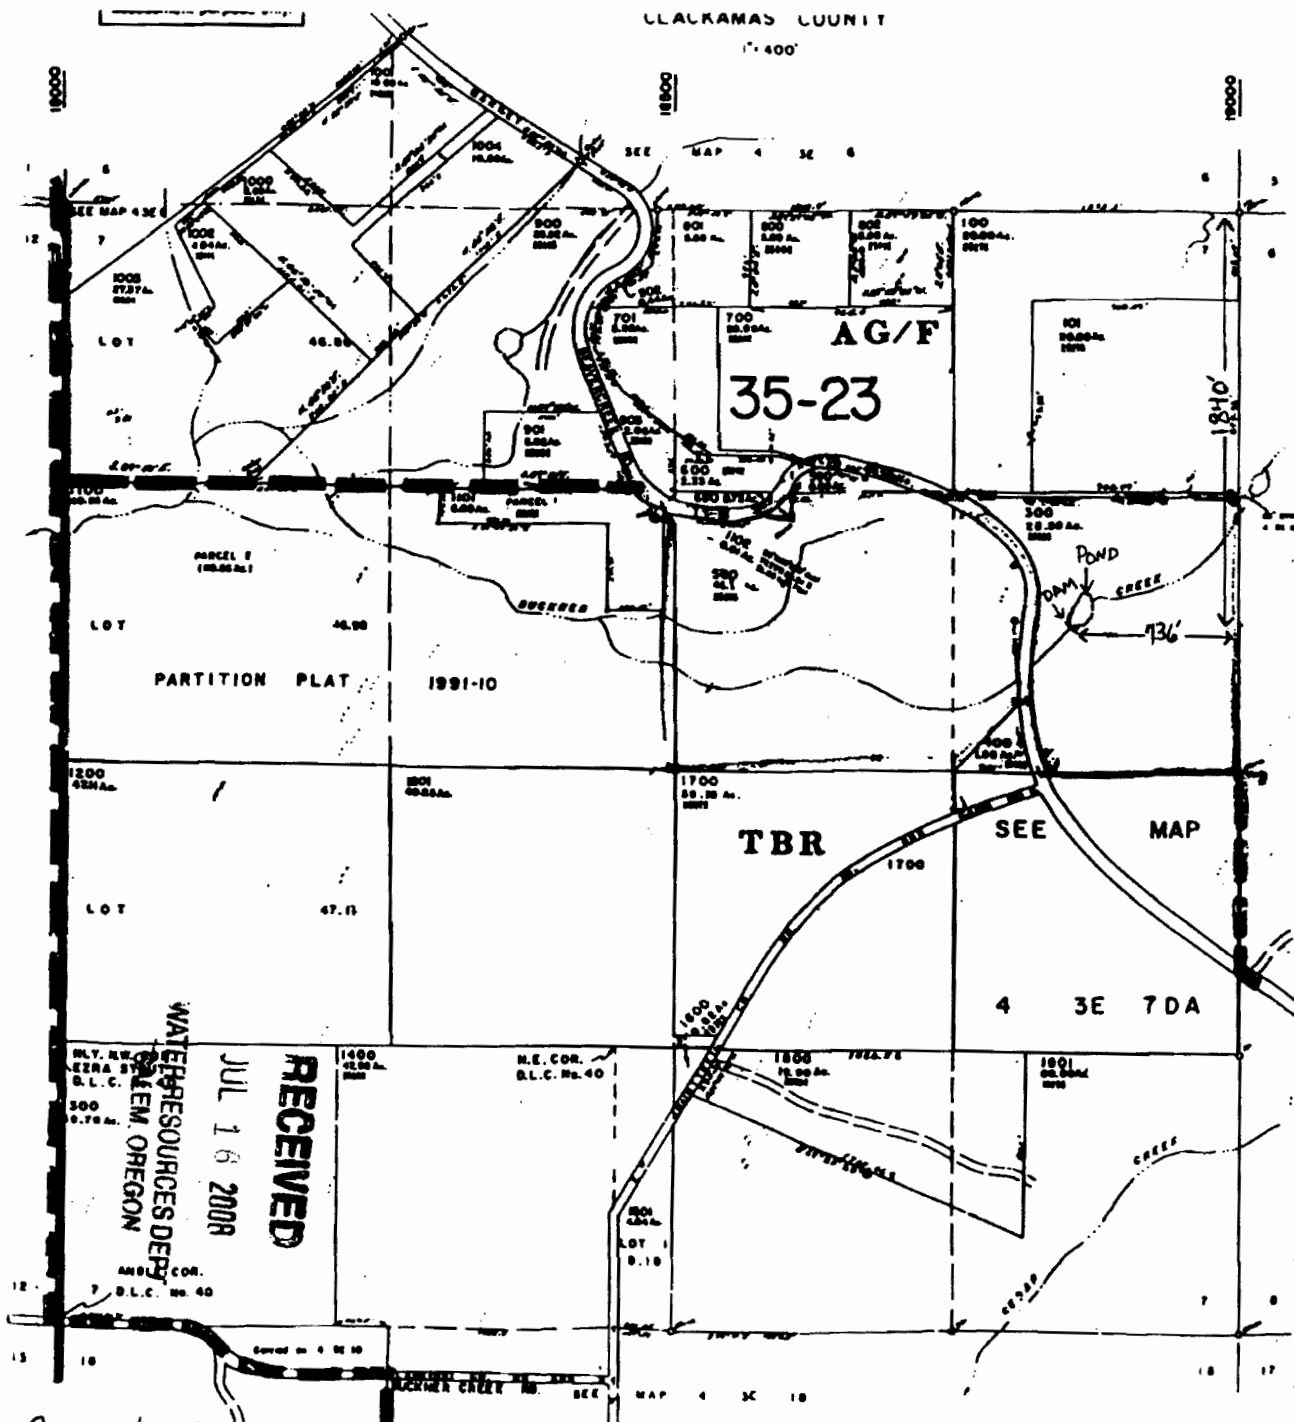

Applicant: Lynn Schell

POD Location:

1) 1840' South and 736' West from the NE Corner of Section 7, T. 4 S., R. 3 E.

Within SE1/4 NE1/4; Tax Lot 300

T. 4 S. R. 3 E. Section 7



Scale: 1" = 800'

25000

4 3E 7
A INDEX

SALEM, OR

JUN 27 2014

RECEIVED BY OWRD

App No R-87231
Permit R-14665

RECEIVED
JUL 16 2008
WATER RESOURCES DEPT
SALEM, OREGON
ANSL COR.
7 D.L.C. No. 40